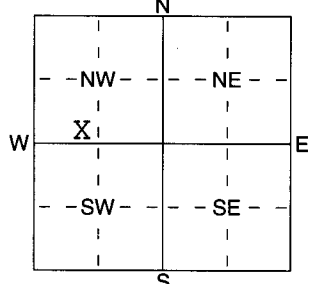


1 LOCATION OF WATER WELL: County: Pratt	Fraction SE 1/4 SW 1/4 NW 1/4	Section Number 26	Township Number T 26 S	Range Number R 11w E/W
---------------------------------------------------	-----------------------------------------	-----------------------------	----------------------------------	----------------------------------

Distance and direction from nearest town or city street address of well if located within city?

3E of Preston, Ks.

2 WATER WELL OWNER: Virgil Young RR#, St. Address, Box # : 520 E. 2nd. City, State, ZIP Code : St. John, KS 67576	Jandie O. Company P.O. Box 442 Great Bend, Ks. 67530	Young #1 Board of Agriculture, Division of Water Resources Application Number: 20030293
---	---------------------------------------------------------------------------------	---

3 LOCATE WELL'S LOCATION WITH AN "X" IN SECTION BOX: 	4 DEPTH OF COMPLETED WELL 80 ft. ELEVATION: unknown
	Depth(s) Groundwater Encountered 1 22 ft. 2 ft. 3 ft. WELL'S STATIC WATER LEVEL 22 ft. below land surface measured on mo/day/yr 12/15/03 Pump test data: Well water was ft. after hours pumping gpm Est. Yield 60 gpm: Well water was ft. after hours pumping gpm WELL WATER TO BE USED AS: 1 Domestic 3 Feedlot 6 Oil field water supply 8 Air conditioning 11 Injection well 2 Irrigation 4 Industrial 7 Domestic (lawn & garden) 9 Dewatering 12 Other (Specify below)
Was a chemical/bacteriological sample submitted to Department? Yes <u>No</u> ; If yes, mo/day/yrs sample was submitted Water Well Disinfected? <u>Yes</u> No	

5 TYPE OF BLANK CASING USED: 1 Steel 2 PVC 3 RMP (SR) 4 ABS 5 Wrought iron 6 Asbestos-Cement 7 Fiberglass 8 Concrete tile 9 Other (specify below) CASING JOINTS: <u>Glued</u> Clamped Welded Threaded	Blank casing diameter 5 in. to 60 ft. Dia in. to ft. Dia in. to ft. Casing height above land surface 12 in., weight 2.8 lbs./ft. Wall thickness or gauge No. Sch. 40
TYPE OF SCREEN OR PERFORATION MATERIAL: 1 Steel 2 Brass 3 Stainless Steel 4 Galvanized Steel 5 Fiberglass 6 Concrete tile 7 PVC 8 RMP (SR) 9 ABS 10 Asbestos-Cement 11 Other (Specify) 12 None used (open hole)	SCREEN OR PERFORATION OPENINGS ARE: 1 Continuous slot 2 Louvered shutter 3 Mill slot 4 Key punched 5 Gauzed wrapped 6 Wire wrapped 7 Torch cut 8 <u>Saw cut</u> 9 Drilled holes 10 Other (specify) ft. 11 None (open hole)
SCREEN-PERFORATED INTERVALS: From 60 ft. to 80 ft., From ft. to ft. GRAVEL PACK INTERVALS: From 23 ft. to 80 ft., From ft. to ft. From ft. to ft., From ft. to ft.	

6 GROUT MATERIAL: 1 Neat cement 2 Cement grout 3 Bentonite 4 Other	Grout Intervals: From 0 ft. to 23 ft., From ft. to ft., From ft. to ft.
What is the nearest source of possible contamination: 1 Septic tank 2 Sewer lines 3 Watertight sewer lines 4 Lateral lines 5 Cess pool 6 Seepage pit 7 Pit privy 8 Sewage lagoon 9 Feedyard 10 Livestock pens 11 Fuel storage 12 Fertilizer storage 13 Insecticide storage 14 Abandoned water well 15 <u>Oil well/Gas well</u> 16 Other (specify below)	Direction from well? West How many feet? 250

FROM	TO	LITHOLOGIC LOG	FROM	TO	PLUGGING INTERVALS
0	2	top sand			
2	9	clay			
9	20	sand and gravel			
20	28	clay			
28	77	sand and gravel			
77	80	clay			

7 CONTRACTOR'S OR LANDOWNER'S CERTIFICATION: This water well was (1) constructed, (2) reconstructed, or (3) plugged under my jurisdiction and was completed on (mo/day/year) 12/15/03 and this record is true to the best of my knowledge and belief. Kansas Water Well Contractor's Licence No 186 This Water Well Record was completed on (mo/day/yr) 12/17/03 under the business name of Kelly's Water Well Service, Inc. by (signature) <i>Kathryn R Good</i>

INSTRUCTIONS: Use typewriter or ball point pen. PLEASE PRESS FIRMLY and PRINT clearly. Please fill in blanks, underline or circle the correct answers. Send top three copies to Kansas Department of Health and Environment, Bureau of Water, Geology Section, 1000 SW Jackson St., Suite 420, Topeka, Kansas 66612-1367. Telephone 785-296-5522. Send one to WATER WELL OWNER and retain one for your records. Fee of \$5.00 for each constructed well.