


1 LOCATION OF WATER WELL: County: Platt Fraction: NW 1/4 NW 1/4 SE 1/4 Section Number: 25 Township Number: T 26 S Range Number: R 11 E

Distance and direction from nearest town or city street address of well if located within city?
1/2 South 4 East 1/2 North 1/2 East South End Location/From Preston

2 WATER WELL OWNER: APPO Energies Inc
 RR#, St. Address, Box #: 10378 N. 281 Hwy Platt, KS
 City, State, ZIP Code: Platt, KS
 Board of Agriculture, Division of Water Resources
 Application Number:

3 LOCATE WELL'S LOCATION WITH AN "X" IN SECTION BOX: 4 DEPTH OF COMPLETED WELL: 60 ft. ELEVATION: _____ ft.

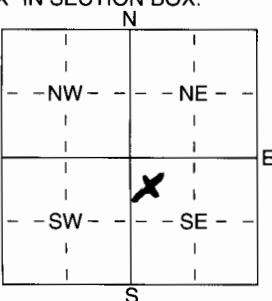

Depth(s) Groundwater Encountered: NA ft. 2 _____ ft. 3 _____ ft.
 WELL'S STATIC WATER LEVEL: NA ft. below land surface measured on mo/day/yr _____
 Pump test data: Well water was _____ ft. after _____ hours pumping _____ gpm
 Est. Yield _____ gpm: Well water was _____ ft. after _____ hours pumping _____ gpm
 WELL WATER TO BE USED AS:
 1 Domestic 3 Feedlot 5 Public water supply 8 Air conditioning 11 Injection well
 2 Irrigation 4 Industrial 6 Oil field water supply 9 Dewatering 12 Other (Specify below)
 7 Domestic (lawn & garden) 10 Monitoring well TEMP SUPPLY WELL

Was a chemical/bacteriological sample submitted to Department? Yes _____ No X; If yes, mo/day/yr sample was submitted
 Water Well Disinfected? Yes X No _____

5 TYPE OF BLANK CASING USED:
 1 Steel 3 RMP (SR) 5 Wrought iron 8 Concrete tile CASING JOINTS: Glued X Clamped _____
 2 PVC 4 ABS 6 Asbestos-Cement 9 Other (specify below) Welded _____
 7 Fiberglass _____ Threaded _____

Blank casing diameter: 5 in. to 60 ft., Dia _____ in. to _____ ft., Dia _____ in. to _____ ft.
 Casing height above land surface: 12 in., weight 160 lbs./ft. Wall thickness or guage No. _____

TYPE OF SCREEN OR PERFORATION MATERIAL:
 1 Steel 3 Stainless Steel 5 Fiberglass X PVC 10 Asbestos-Cement
 2 Brass 4 Galvanized Steel 6 Concrete tile 9 ABS 11 Other (Specify) _____
 12 None used (open hole)

SCREEN OR PERFORATION OPENINGS ARE:
X Continuous slot 3 Mill slot 5 Gauzed wrapped 8 Saw cut 11 None (open hole)
 2 Louvered shutter 4 Key punched 6 Wire wrapped 9 Drilled holes
 7 Torch cut 10 Other (specify) _____ ft.

SCREEN-PERFORATED INTERVALS: From 60 ft. to 40 ft., From _____ ft. to _____ ft.
 GRAVEL PACK INTERVALS: From 60 ft. to 23 ft., From _____ ft. to _____ ft.
 From _____ ft. to _____ ft., From _____ ft. to _____ ft.

6 GROUT MATERIAL: 23 Neat cement X Cement grout 3 Bentonite 4 Other _____
 Grout Intervals: From 23 ft. to 0 ft., From _____ ft. to _____ ft., From _____ ft. to _____ ft.

What is the nearest source of possible contamination:
 1 Septic tank 4 Lateral lines 7 Pit privy 10 Livestock pens 14 Abandoned water well
 2 Sewer lines 5 Cess pool 8 Sewage lagoon 11 Fuel storage 15 Oil well/Gas well
 3 Watertight sewer lines 6 Seepage pit 9 Feedyard 12 Fertilizer storage 16 Other (specify below)
 13 Insecticide storage Nothing on Location
 Direction from well? _____ How many feet? _____

FROM	TO	LITHOLOGIC LOG	FROM	TO	PLUGGING INTERVALS
<u>0</u>	<u>3</u>	<u>Black Clay</u>			
<u>3</u>	<u>8</u>	<u>White Clay</u>			
<u>8</u>	<u>32</u>	<u>FINE SAND</u>			
<u>32</u>	<u>44</u>	<u>Tan Clay</u>			
<u>44</u>	<u>60</u>	<u>Coarse Sand</u>			

7 CONTRACTOR'S OR LANDOWNER'S CERTIFICATION: This water well was X (1) constructed, (2) reconstructed, or (3) plugged under my jurisdiction and was completed on (mo/day/year) 10-3-05 and this record is true to the best of my knowledge and belief. Kansas Water Well Contractor's Licence No. 672 This Water Well Record was completed on (mo/day/yr) 10-4-05 under the business name of Crowd's Water Well by (signature) _____