


1 LOCATION OF WATER WELL: County: PRATT Fraction SE 1/4 SW 1/4 NW 1/4 Section Number 17 Township Number T 26 S Range Number R 11 EW

Distance and direction from nearest town or city street address of well if located within city?
 1/2 N 1/2 W OF PRESTON, K.S.

2 WATER WELL OWNER: RAYMOND OIL CO.
 RR#, St. Address, Box #: BOX 48788 Board of Agriculture, Division of Water Resources
 City, State, ZIP Code: WICHITA, KS. 67201 Application Number: T91-0460

3 LOCATE WELL'S LOCATION WITH AN "X" IN SECTION BOX:

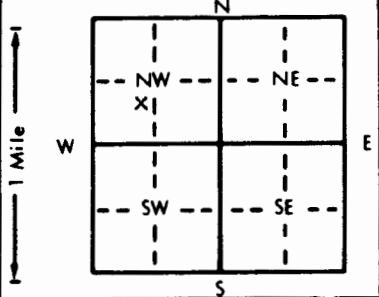

4 DEPTH OF COMPLETED WELL: 10.1 ft. ELEVATION:
 Depth(s) Groundwater Encountered 1. ft. 2. ft. 3. ft.
 WELL'S STATIC WATER LEVEL . . . 39 . . . ft. below land surface measured on mo/day/yr
 Pump test data: Well water was ft. after hours pumping gpm
 Est. Yield gpm: Well water was ft. after hours pumping gpm
 Bore Hole Diameter. . . 9 . . . in. to ft., and in. to ft.
 WELL WATER TO BE USED AS: 5 Public water supply 8 Air conditioning 11 Injection well
 1 Domestic 3 Feedlot x6 Oil field water supply 9 Dewatering 12 Other (Specify below)
 2 Irrigation 4 Industrial 7 Lawn and garden only 10 Monitoring well
 Was a chemical/bacteriological sample submitted to Department? Yes. No. x; If yes, mo/day/yr sample was submitted
 Water Well Disinfected? Yes No x

5 TYPE OF BLANK CASING USED: 5 Wrought iron 8 Concrete tile CASING JOINTS: Glued x Clamped
 1 Steel 3 RMP (SR) 6 Asbestos-Cement 9 Other (specify below) Welded
 x2 PVC 4 ABS 7 Fiberglass Threaded
 Blank casing diameter . . . 5 . . . in. to . . . 9.1 . . . ft., Dia in. to ft., Dia in. to ft.
 Casing height above land surface. . . 12 . . . in., weight lbs./ft. Wall thickness or gauge No.

TYPE OF SCREEN OR PERFORATION MATERIAL: xx7 PVC 10 Asbestos-cement
 1 Steel 3 Stainless steel 5 Fiberglass 8 RMP (SR) 11 Other (specify)
 2 Brass 4 Galvanized steel 6 Concrete tile 9 ABS 12 None used (open hole)

SCREEN OR PERFORATION OPENINGS ARE: 5 Gauzed wrapped 8 Saw cut 11 None (open hole)
 1 Continuous slot x Mill slot 6 Wire wrapped 9 Drilled holes
 2 Louvered shutter 4 Key punched 7 Torch cut 10 Other (specify)

SCREEN-PERFORATED INTERVALS: From . . . 9.1 . . . ft. to . . . 10.1 . . . ft., From ft. to ft.
 From ft. to ft., From ft. to ft.
 GRAVEL PACK INTERVALS: From . . . 20 . . . ft. to . . . 10.1 . . . ft., From ft. to ft.
 From ft. to ft., From ft. to ft.

6 GROUT MATERIAL: 1 Neat cement 2 Cement grout xx8 Bentonite 4 Other
 Grout Intervals: From . . . 0 . . . ft. to . . . 20 . . . ft., From ft. to ft., From ft. to ft.

What is the nearest source of possible contamination:
 1 Septic tank 4 Lateral lines 7 Pit privy 10 Livestock pens 14 Abandoned water well
 2 Sewer lines 5 Cess pool 8 Sewage lagoon 11 Fuel storage 15 Oil well/Gas well
 3 Watertight sewer lines 6 Seepage pit 9 Feedyard 12 Fertilizer storage 16 Other (specify below)
 13 Insecticide storage . . . NONE
 Direction from well? How many feet?

FROM	TO	LITHOLOGIC LOG	FROM	TO	PLUGGING INTERVALS
0	3	TOP SOIL			
3	20	CLAY			
20	57	GRAVEL			
57	84	CLAY			
84	101	GRAVEL			

7 CONTRACTOR'S OR LANDOWNER'S CERTIFICATION: This water well was (1) constructed, (2) reconstructed, or (3) plugged under my jurisdiction and was completed on (mo/day/year) . . . 10-28-91 . . . and this record is true to the best of my knowledge and belief. Kansas
 Water Well Contractor's License No. . . . 4628 . . . This Water Well Record was completed on (mo/day/yr) . . . 3-16-92
 under the business name of SAM'S WATER WELL SERVICE by (signature) *Erica Rayburn*

OFFICE USE ONLY
 T
 R
 EW
 SEC
 1/4
 1/4
 1/4