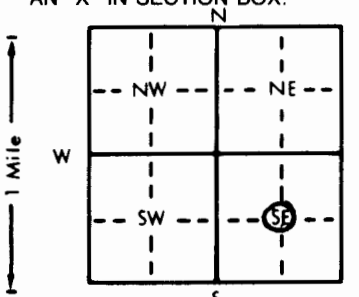


1 LOCATION OF WATER WELL: Fraction Near the Center Section Number Township Number Range Number
 County: Pratt NC 1/4 NC 1/4 SE 1/4 22 T 26 S R 11 E/W

Distance and direction from nearest town or city street address of well if located within city?
 Approximately 3 miles east of Preston, KS

2 WATER WELL OWNER: Merle Trinkle
 RR#, St. Address, Box #: Route 1 Board of Agriculture, Division of Water Resources
 City, State, ZIP Code: Preston, KS 67569 Application Number: 19,234

3 LOCATE WELL'S LOCATION WITH AN "X" IN SECTION BOX:

 4 DEPTH OF COMPLETED WELL: 140 ft. ELEVATION: unknown
 Depth(s) Groundwater Encountered 1. ft. 2. ft. 3. ft.
 WELL'S STATIC WATER LEVEL: 23 ft. below land surface measured on mo/day/yr
 Pump test data: Well water was not ch'd. ft. after hours pumping gpm
 Est. Yield unknown gpm: Well water was ft. after hours pumping gpm
 Bore Hole Diameter: in. to ft., and in. to ft.
 WELL WATER TO BE USED AS: 5 Public water supply 8 Air conditioning 11 Injection well
 1 Domestic 3 Feedlot 6 Oil field water supply 9 Dewatering 12 Other (Specify below)
 2 Irrigation 4 Industrial 7 Lawn and garden only 10 Monitoring well
 Was a chemical/bacteriological sample submitted to Department? Yes. No. ; If yes, mo/day/yr sample was submitted
 Water Well Disinfected? Yes No

5 TYPE OF BLANK CASING USED: 5 Wrought iron 8 Concrete tile CASING JOINTS: Glued Clamped
 1 Steel 3 RMP (SR) 6 Asbestos-Cement 9 Other (specify below) Welded
 2 PVC 4 ABS 7 Fiberglass Threaded.
 Blank casing diameter: 16 in. to 69 ft., Dia: 16 in. to 120 ft., Dia: in. to ft.
 Casing height above land surface: 12 in., weight: 42.05 lbs./ft. Wall thickness or gauge No.: 250
 TYPE OF SCREEN OR PERFORATION MATERIAL: 7 PVC 10 Asbestos-cement
 1 Steel 3 Stainless steel 5 Fiberglass 8 RMP (SR) 11 Other (specify)
 2 Brass 4 Galvanized steel 6 Concrete tile 9 ABS 12 None used (open hole)
 SCREEN OR PERFORATION OPENINGS ARE: 5 Gauzed wrapped 8 Saw cut 11 None (open hole)
 1 Continuous slot 3 Mill slot 6 Wire wrapped 9 Drilled holes
 2 Louvered shutter 4 Key punched 7 Torch cut 10 Other (specify) Bridge Slot
 SCREEN-PERFORATED INTERVALS: From 69 ft. to 109 ft., From ft. to ft.
 From 120 ft. to 140 ft., From ft. to ft.
 GRAVEL PACK INTERVALS: From ft. to ft., From ft. to ft.
 From ft. to ft., From ft. to ft.

6 GROUT MATERIAL: 1 Neat cement 2 Cement grout 3 Bentonite 4 Other
 Grout Intervals: From ft. to ft., From ft. to ft., From ft. to ft.
 What is the nearest source of possible contamination: 10 Livestock pens 14 Abandoned water well
 1 Septic tank 4 Lateral lines 7 Pit privy 11 Fuel storage 15 Oil well/Gas well
 2 Sewer lines 5 Cess pool 8 Sewage lagoon 12 Fertilizer storage 16 Other (specify below)
 3 Watertight sewer lines 6 Seepage pit 9 Feedyard 13 Insecticide storage None known
 Direction from well? How many feet?

FROM	TO	LITHOLOGIC LOG	FROM	TO	PERFORATION INTERVALS
0	2	Topsoil	104	108	Clay, brown, sandy
2	22	Clay, brown and gray	108	128	Clay, brown and gray
22	28	Sand and Gravel, fine	128	135	Sand and Gravel, fine
28	42	Clay and limestone, brown and white	135	140	Sand and Gravel, fine to medium
42	56	Sand and Gravel, very fine to fine, some medium		140	Red Shale
56	59	Clay, brown			
59	63	Sand and Gravel, fine			
63	71	Clay, yellow and gray			
71	90	Sand and Gravel, very fine to fine, yellow clay streak at 78'			
90	92	Clay, gray			
92	96	Sand and Gravel, fine			
96	99	Clay, gray			
99	104	Sand and Gravel, fine			

7 CONTRACTOR'S OR LANDOWNER'S CERTIFICATION: This water well was (1) constructed, (2) reconstructed, or (3) plugged under my jurisdiction and was completed on (mo/day/year) 7-3-90 and this record is true to the best of my knowledge and belief. Kansas Water Well Contractor's License No. 185 This Water Well Record was completed on (mo/day/yr) 7-13-90 under the business name of Clarke Well & Equipment, Inc. by (signature) [Signature]

OFFICE USE ONLY T R EW SEC 1/4 1/4 1/4