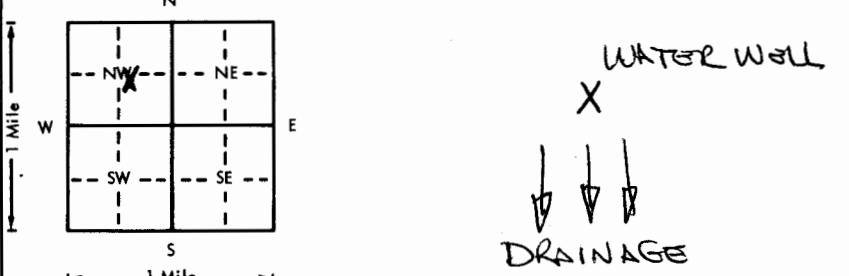


USE TYPEWRITER OR BALL POINT PEN-PRESS FIRMLY, PRINT CLEARLY.

WATER WELL RECORD
KSA 82a-1201-1215

Kansas Department of Health and Environment-Division of Environment
(Water well Contractors)
Topeka, Kansas 66620

1. Location of well: County PRATT Fraction NW 1/4 SE 1/4 NW 1/4 Section number 24 Township number T 26 S R 11 Range number E/W	
2. Distance and direction from nearest town or city: 1/2 W 3/4 N 1/4 E Street address of well location if in city: OF PRESTON, KS 3. Owner of well: LES BROWN R.R. or street: City, state, zip code: PRESTON, KS	
4. Locate with "X" in section below: Sketch map: 	
6. Bore hole dia. 30 in. Completion date 2 MARCH 77 Well depth 94 ft.	
7. Cable tool <input type="checkbox"/> Rotary <input type="checkbox"/> Driven <input type="checkbox"/> Dug <input type="checkbox"/> Hollow rod <input type="checkbox"/> Jetted <input type="checkbox"/> Bored <input checked="" type="checkbox"/> Reverse rotary	
8. Use: Domestic <input type="checkbox"/> Public supply <input type="checkbox"/> Industry <input checked="" type="checkbox"/> Irrigation <input type="checkbox"/> Air conditioning <input type="checkbox"/> Stock <input type="checkbox"/> Lawn <input type="checkbox"/> Oil field water <input type="checkbox"/> Other	
9. Casing: Material STL Height Above or below Threading <input type="checkbox"/> Welded <input checked="" type="checkbox"/> Surface 12 in. RMP <input type="checkbox"/> PVC <input type="checkbox"/> Weight <input type="checkbox"/> lbs./ft. Dia. 1 1/2 in. to 94 ft. depth Wall Thickness: inches or Dia. <input type="checkbox"/> in. to <input type="checkbox"/> ft. depth gage No. 188	
10. Screen: Manufacturer's name WA BROWN Type FRELO Dia. 1 1/2" Slot/gauze 1/8 Length 40' Set between 54 ft. and 94 ft. Gravel pack? Yes Size range of material 1/4 - 1/2	
11. Static water level: 26 ft. below land surface Date 2 MAR 77 mo./day/yr.	
12. Pumping level below land surfaces: 62 ft. after 1 hrs. pumping 672 g.p.m. 64 ft. after <input type="checkbox"/> hrs. pumping 708 g.p.m. Estimated maximum yield 800 g.p.m.	
13. Water sample submitted: <input checked="" type="checkbox"/> Yes <input type="checkbox"/> No Date <input type="checkbox"/> mo./day/yr.	
14. Well head completion: <input type="checkbox"/> Pitless adapter 12 Inches above grade	
15. Well grouted? Yes With: <input type="checkbox"/> Neat cement <input checked="" type="checkbox"/> Bentonite <input type="checkbox"/> Concrete Depth: From 0 ft. to 10 ft.	
16. Nearest source of possible contamination: NONE ft. Direction Type NONE Well disinfected upon completion? <input checked="" type="checkbox"/> Yes <input type="checkbox"/> No	
17. Pump: <input type="checkbox"/> Not installed Manufacturer's name Flowly Model number <input type="checkbox"/> HP 60 Volts <input type="checkbox"/> Length of drop pipe 80 ft. capacity 700 g.p.m. Type: <input type="checkbox"/> Submersible <input checked="" type="checkbox"/> Turbine <input type="checkbox"/> Jet <input type="checkbox"/> Reciprocating <input type="checkbox"/> Centrifugal <input type="checkbox"/> Other	
(Use a second sheet if needed)	
18. Elevation: Topography: <input type="checkbox"/> Hill <input type="checkbox"/> Slope <input checked="" type="checkbox"/> Upland <input type="checkbox"/> Valley	19. Remarks: 5' X 10' CONCRETE SLAB AT SURFACE
20. Water well contractor's certification: This well was drilled under my jurisdiction and this report is true to the best of my knowledge and belief. CENTRAL Well & Pump 325 Business name License No. Address 121 S. TAYLOR PRATT Signed Bob Monnich Date 2 MAR 77 Authorized representative	

26
 11
 24
 NW SE NW
 1/4 1/4 1/4
 Sec

Forward the white, blue and pink copies to the Department of Health and Environment

Form WWC-5