


1 LOCATION OF WATER WELL: Fraction SW 1/4 NW 1/4 NW 1/4 Section Number 29 Township Number T 26 S R 11 E/W Range Number 11

Distance and direction from nearest town or city street address of well if located within city?  
145' E of MAIN ST CENTERLINE & 8' NORTH OF FENCE

2 WATER WELL OWNER: MORGAN TRINKLE  
 RR#, St. Address, Box #: RT 1 Box 165  
 City, State, ZIP Code: PRESTON, KS 67569  
 Board of Agriculture, Division of Water Resources  
 Application Number: \_\_\_\_\_

3 LOCATE WELL'S LOCATION WITH AN "X" IN SECTION BOX:  
 4 DEPTH OF COMPLETED WELL: 25.5 ft. ELEVATION: 1835.27 T.O.C.

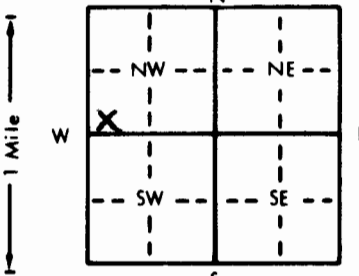

Depth(s) Groundwater Encountered 1 17-18 ft. 2 \_\_\_\_\_ ft. 3 \_\_\_\_\_ ft.  
 WELL'S STATIC WATER LEVEL 1557 ft. below land surface measured on mo/day/yr 2-13-94  
 Pump test data: Well water was \_\_\_\_\_ ft. after \_\_\_\_\_ hours pumping \_\_\_\_\_ gpm  
 Est. Yield \_\_\_\_\_ gpm Well water was \_\_\_\_\_ ft. after \_\_\_\_\_ hours pumping \_\_\_\_\_ gpm  
 Bore Hole Diameter: 7 7/8 in. to 25.5 ft., and \_\_\_\_\_ in. to \_\_\_\_\_ ft.  
 WELL WATER TO BE USED AS:  
 5 Public water supply 8 Air conditioning 11 Injection well  
 1 Domestic 3 Feedlot 6 Oil field water supply 9 Dewatering 12 Other (Specify below)  
 2 Irrigation 4 Industrial 7 Lawn and garden only 10 Monitoring well mw 4  
 Was a chemical/bacteriological sample submitted to Department? Yes \_\_\_\_\_ No X; If yes, mo/day/yr sample was sub-  
 mitted \_\_\_\_\_ Water Well Disinfected? Yes \_\_\_\_\_ No X

5 TYPE OF BLANK CASING USED:  
 1 Steel 3 RMP (SR) 6 Asbestos-Cement 9 Other (specify below) Welded \_\_\_\_\_  
 2 PVC 4 ABS 7 Fiberglass Threaded X  
 Blank casing diameter 2 in. to 5 ft., Dia 2 in. to 150 ft., Dia \_\_\_\_\_ in. to \_\_\_\_\_ ft.  
 Casing height above land surface -6 in., weight \_\_\_\_\_ lbs./ft. Wall thickness or gauge No. Sch 40

TYPE OF SCREEN OR PERFORATION MATERIAL:  
 1 Steel 3 Stainless steel 5 Fiberglass 8 RMP (SR) 10 Asbestos-cement  
 2 Brass 4 Galvanized steel 6 Concrete tile 9 ABS 11 Other (specify) \_\_\_\_\_  
 12 None used (open hole)  
 SCREEN OR PERFORATION OPENINGS ARE:  
 1 Continuous slot 3 Mill slot 6 Wire wrapped 8 Saw cut 11 None (open hole)  
 2 Louvered shutter 4 Key punched 7 Torch cut 10 Other (specify) \_\_\_\_\_

SCREEN-PERFORATED INTERVALS: From 15 ft. to 25 ft., From \_\_\_\_\_ ft. to \_\_\_\_\_ ft.  
 From \_\_\_\_\_ ft. to \_\_\_\_\_ ft., From \_\_\_\_\_ ft. to \_\_\_\_\_ ft.  
 GRAVEL PACK INTERVALS: From 10.4 ft. to 25.5 ft., From \_\_\_\_\_ ft. to \_\_\_\_\_ ft.  
 From \_\_\_\_\_ ft. to \_\_\_\_\_ ft., From \_\_\_\_\_ ft. to \_\_\_\_\_ ft.

6 GROUT MATERIAL: 1 Neat cement 2 Cement grout 3 Bentonite 4 Other \_\_\_\_\_  
 Grout intervals: From 1.0 ft. to 10.4 ft., From 10.4 ft. to 13.6 ft., From \_\_\_\_\_ ft. to \_\_\_\_\_ ft.  
 What is the nearest source of possible contamination:  
 1 Septic tank 4 Lateral lines 7 Pit privy 10 Livestock pens 14 Abandoned water well  
 2 Sewer lines 5 Cess pool 8 Sewage lagoon 11 Fuel storage 15 Oil well/Gas well  
 3 Watertight sewer lines 6 Seepage pit 9 Feedyard 12 Fertilizer storage 16 Other (specify below)  
 13 Insecticide storage \_\_\_\_\_  
 Direction from well? SE How many feet? 130 - LAST PIT

FROM	TO	LITHOLOGIC LOG	FROM	TO	PLUGGING INTERVALS
0	1	SOIL: dark, organic			
1	5	SILT brown w/ SAND, fine to medium grained, well sorted, round 10%			
5	7	CLAY, black, with sand, fine to medium grained, round, 10%			
7	10	CLAY, lt tan SILTY, w/ fine CALICHE nodules and trace SAND, fine grained, 10%. At 10' CALICHE in veins and evident increases.			
10	16	CLAY, lt orange, w/ SAND, SAA, wet at 16-17'			
16	28	SAND, tan, fine to coarse grained, well sorted, subangular to sub round			

7 CONTRACTOR'S OR LANDOWNER'S CERTIFICATION: This water well was (1) constructed, (2) reconstructed, or (3) plugged under my jurisdiction and was completed on (mo/day/year) 2-11-94 and this record is true to the best of my knowledge and belief. Kansas Water Well Contractor's License No. 183 This Water Well Record was completed on (mo/day/yr) 2-8-94 under the business name of TBST by (signature) Clay P. Rye

OFFICE USE ONLY

T 26

R 11

E/W

SEC.

29

SW 1/4 NW 1/4 NW 1/4