WATER WELL RECORD Form WWC-5 KSA 82a-1212

1 LOCATION OF WATER WELL: County: Pratt | Fraction: NC SW ¼ CENTER | Section Number: 1 | Township Number: T 26 S | Range Number: R 12 E/W

Distance and direction from nearest town or city street address of well if located within city?

3 Miles North 1 3/4Miles West ¼ North Of Preston,Kans.

2 WATER WELL OWNER: CARR Farms,Inc. O/O 1ST National Bank

RR#, St. Address, Box # : Pratt,Kansas 67124

City, State, ZIP Code :

Board of Agriculture, Division of Water Resources Application Number:

3 LOCATE WELL'S LOCATION WITH AN "X" IN SECTION BOX:

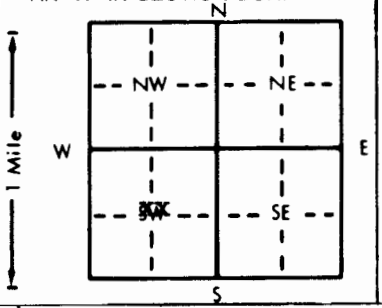

4 DEPTH OF COMPLETED WELL 155' ft. ELEVATION:

Depth(s) Groundwater Encountered 1. 46' ft. 2. ft. 3. ft.

WELL'S STATIC WATER LEVEL 32' ft. below land surface measured on mo/day/yr Feb 3 1997

Pump test data: Well water was ft. after hours pumping gpm

Est. Yield 1000 gpm: Well water was ft. after hours pumping gpm

Bore Hole Diameter 30" in. to 155' ft., and in. to ft.

WELL WATER TO BE USED AS: 1 Domestic 3 Feedlot 5 Public water supply 6 Oil field water supply 7 Lawn and garden only 8 Air conditioning 9 Dewatering 10 Monitoring well 11 Injection well 12 Other (Specify below)

X 2 Irrigation 4 Industrial

Was a chemical/bacteriological sample submitted to Department? Yes No X; If yes, mo/day/yr sample was submitted

Water Well Disinfected? Yes X No

5 TYPE OF BLANK CASING USED: 1 Steel 3 RMP (SR) X 2 PVC 4 ABS 5 Wrought iron 6 Asbestos-Cement 7 Fiberglass 8 Concrete tile 9 Other (specify below)

CASING JOINTS: Glued X Clamped Welded Threaded

Blank casing diameter 16" in. to 110' ft., Dia in. to ft., Dia in. to ft.

Casing height above land surface 12" in., weight 16.150 lbs./ft. Wall thickness or gauge No. .500

TYPE OF SCREEN OR PERFORATION MATERIAL: X 7 PVC 1 Steel 2 Brass 3 Stainless steel 4 Galvanized steel 5 Fiberglass 6 Concrete tile 8 RMP (SR) 9 ABS 10 Asbestos-cement 11 Other (specify) 12 None used (open hole)

SCREEN OR PERFORATION OPENINGS ARE: 1 Continuous slot X 3 Mill slot 2 Louvered shutter 4 Key punched 5 Gauzed wrapped 6 Wire wrapped 7 Torch cut 8 Saw cut 9 Drilled holes 10 Other (specify) 11 None (open hole)

SCREEN-PERFORATED INTERVALS: From 155' ft. to 110' ft., From ft. to ft.

From ft. to ft., From ft. to ft.

GRAVEL PACK INTERVALS: From ft. to ft., From ft. to ft.

From 155' ft. to 20' ft., From ft. to ft.

6 GROUT MATERIAL: 1 Neat cement X Cement grout 3 Bentonite 4 Other

Grout Intervals: From 20' ft. to 0' ft., From ft. to ft., From ft. to ft.

What is the nearest source of possible contamination:

X 1 Septic tank 2 Sewer lines 3 Watertight sewer lines 4 Lateral lines 5 Cess pool 6 Seepage pit 7 Pit privy 8 Sewage lagoon 9 Feedyard 10 Livestock pens 11 Fuel storage 12 Fertilizer storage 13 Insecticide storage 14 Abandoned water well 15 Oil well/Gas well 16 Other (specify below)

Direction from well? Southwest How many feet? App:1850'

FROM	TO	LITHOLOGIC LOG	FROM	TO	LOG
0'	4'	Loamy Top Soil.	114'	131'	Course Sand & Fine Gravel.
4'	29'	Brown Clay.	13'	132'	Clay Strip.
29'	46'	Grey Clay.	132'	154'	Course Sand & Fine Gravel.
46'	53'	Fine Sand.	154'	155'	Course Sand & Fine Gravel.
53'	56'	Brown Clay.		155'	Clay Very Hard.
56'	63'	Clay W/Clay strips.			
63'	65'	Lime.			
65'	70'	Medium Fine Sand.			
70'	78'	Course Sand.			
78'	79'	Sandy Clay.(Hard).			
79'	80'	Course Sand.			
80'	82'	Clay.			
82'	87'	Fine Sand.			
87'	100'	Course Sand.			
100'	114'	Clay.			

7 CONTRACTOR'S OR LANDOWNER'S CERTIFICATION: This water well was (1) constructed, (2) reconstructed, or (3) plugged under my jurisdiction and was completed on (mo/day/year) Feb 3 1997 and this record is true to the best of my knowledge and belief. Kansas Water Well Contractor's License No. 112 This Water Well Record was completed on (mo/day/yr) April 30 1997 under the business name of Wells Drilling Co. by (signature) Dal Wells

INSTRUCTIONS: Use typewriter or ball point pen. *PLEASE PRESS FIRMLY* and *PRINT* clearly. Please fill in blanks, underline or circle the correct answers. Send top three copies to Kansas Department of Health and Environment, Bureau of Water, Topeka, Kansas 66620-0001. Telephone: 913-296-5545. Send one to WATER WELL OWNER and retain one for your records.

OFFICE USE ONLY T R E/W SEC. ¼ ¼ ¼