


1 LOCATION OF WATER WELL: County: **Pratt** Fraction: **NE 1/4 NE 1/4 NW 1/4** Section Number: **36 33** Township Number: **T 26 S** Range Number: **R 12W E/W**

Distance and direction from nearest town or city street address of well if located within city?
1N, 5E of Iuka, Ks.

2 WATER WELL OWNER: **George Green** **White & Ellis Drilling Co. Inc.** ~~George Green #1~~
 RR#, St. Address, Box #: **1102 Myrtle** **P. O. Box 1586** Board of Agriculture, Division of Water Resources
 City, State, ZIP Code: **Pratt, Ks. 67124** **Great Bend, KS. 67530** Application Number: **970439**

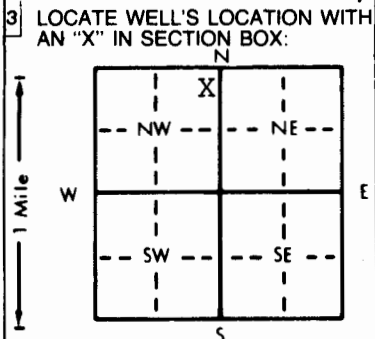

4 DEPTH OF COMPLETED WELL: **125** ft. ELEVATION: **unknown**
 Depth(s) Groundwater Encountered: 1. **50** ft. 2. _____ ft. 3. _____ ft.
 WELL'S STATIC WATER LEVEL: **50** ft. below land surface measured on mo/day/yr **11-28-97**
 Pump test data: Well water was _____ ft. after _____ hours pumping _____ gpm
 Est. Yield **40** gpm: Well water was _____ ft. after _____ hours pumping _____ gpm
 Bore Hole Diameter: **8** in. to **125** ft., and _____ in. to _____ ft.
 WELL WATER TO BE USED AS: 5 Public water supply 8 Air conditioning 11 Injection well
 1 Domestic 3 Feedlot 6 Oil field water supply 9 Dewatering 12 Other (Specify below)
 2 Irrigation 4 Industrial 7 Lawn and garden only 10 Monitoring well
 Was a chemical/bacteriological sample submitted to Department? Yes No; If yes, mo/day/yr sample was submitted _____
 Water Well Disinfected? Yes _____ No _____

5 TYPE OF BLANK CASING USED:
 1 Steel 3 RMP (SR) 5 Wrought iron 8 Concrete tile CASING JOINTS: Glued _____ Clamped _____
 2 PVC 4 ABS 6 Asbestos-Cement 9 Other (specify below) Welded _____
 7 Fiberglass _____ Threaded _____
 Blank casing diameter: **5** in. to **85** ft., Dia _____ in. to _____ ft., Dia _____ in. to _____ ft.
 Casing height above land surface: **12** in., weight **2.8** lbs./ft. Wall thickness or gauge No. Sch. 40
 TYPE OF SCREEN OR PERFORATION MATERIAL:
 1 Steel 3 Stainless steel 5 Fiberglass 7 PVC 10 Asbestos-cement
 2 Brass 4 Galvanized steel 6 Concrete tile 8 RMP (SR) 11 Other (specify) _____
 9 ABS 12 None used (open hole)
 SCREEN OR PERFORATION OPENINGS ARE:
 1 Continuous slot 3 Mill slot 5 Gauzed wrapped 8 Saw cut 11 None (open hole)
 2 Louvered shutter 4 Key punched 6 Wire wrapped 9 Drilled holes
 7 Torch cut 10 Other (specify) _____
 SCREEN-PERFORATED INTERVALS: From **85** ft. to **125** ft., From _____ ft. to _____ ft.
 From _____ ft. to _____ ft., From _____ ft. to _____ ft.
 GRAVEL PACK INTERVALS: From **20** ft. to **72** ft., From **75** ft. to **125** ft.
 From _____ ft. to _____ ft., From _____ ft. to _____ ft.

6 GROUT MATERIAL: 1 Neat cement 2 Cement grout 3 Bentonite 4 Other _____
 Grout Intervals: From **0** ft. to **20** ft., From **72** ft. to **75** ft., From _____ ft. to _____ ft.
 What is the nearest source of possible contamination:
 1 Septic tank 4 Lateral lines 7 Pit privy 10 Livestock pens 14 Abandoned water well
 2 Sewer lines 5 Cess pool 8 Sewage lagoon 11 Fuel storage 15 Oil well/Gas well
 3 Watertight sewer lines 6 Seepage pit 9 Feedyard 12 Fertilizer storage 16 Other (specify below) _____
 13 Insecticide storage _____
 Direction from well? **West** How many feet? **125**

FROM	TO	LITHOLOGIC LOG	FROM	TO	PLUGGING INTERVALS
0	50	top soil and clay			
50	65	sandy clay			
65	85	fine sand			
85	125	small gravel			

7 CONTRACTOR'S OR LANDOWNER'S CERTIFICATION: This water well was (1) constructed, (2) reconstructed, or (3) plugged under my jurisdiction and was completed on (mo/day/year) **11-28-97** and this record is true to the best of my knowledge and belief. Kansas Water Well Contractor's License No. **186**. This Water Well Record was completed on (mo/day/yr) **11-30-97** under the business name of **Kelly's Water Well Service, Inc.** by (signature) *Kathryn L. Wood*

OFFICE USE ONLY T R EW SEC 1/4 1/4 1/4