


1 LOCATION OF WATER WELL:	Fraction	Section Number	Township Number	Range Number
County: Pratt	1/4 NC 1/4 NW 1/4	12	T 26 S	R 12 E/W

Distance and direction from nearest town or city street address of well if located within city?
 Approximately 2 3/4 miles north and 1 3/4 miles west of Preston

2 WATER WELL OWNER: Kenneth Rundell
 RR#, St. Address, Box #: 470 Lake Road
 City, State, ZIP Code: Pratt, KS 67124
 Board of Agriculture, Division of Water Resources
 Application Number: 42,611

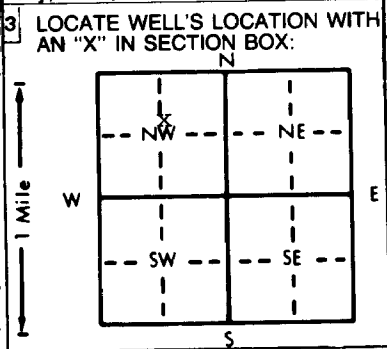

4 DEPTH OF COMPLETED WELL: 78.5 ft. ELEVATION: unknown

Depth(s) Groundwater Encountered 1. ft. 2. ft. 3. ft.

WELL'S STATIC WATER LEVEL: 27 ft. below land surface measured on mo/day/yr 5-11-99

Pump test data: Well water was not ch'd ft. after hours pumping gpm

Est. Yield unknown gpm: Well water was ft. after hours pumping gpm

Bore Hole Diameter: 24 in. to 78 ft., and in. to ft.

WELL WATER TO BE USED AS:

5 Public water supply	8 Air conditioning	11 Injection well
1 Domestic	3 Feedlot	6 Oil field water supply
2 Irrigation	4 Industrial	7 Lawn and garden only
		10 Monitoring well

Was a chemical/bacteriological sample submitted to Department? Yes. No. If yes, mo/day/yr sample was submitted

Water Well Disinfected? Yes No

5 TYPE OF BLANK CASING USED:

1 Steel	3 RMP (SR)	5 Wrought iron	8 Concrete tile	CASING JOINTS: Glued <input checked="" type="checkbox"/> Clamped
2 PVC	4 ABS	6 Asbestos-Cement	9 Other (specify below)	Welded
		7 Fiberglass		Threaded

Blank casing diameter: 10 3/4 in. to 57 ft., Dia. in. to ft., Dia. in. to ft.

Casing height above land surface: 18 in., weight: 9.03 lbs./ft. Wall thickness or gauge No. 413

TYPE OF SCREEN OR PERFORATION MATERIAL:

1 Steel	3 Stainless steel	5 Fiberglass	8 RMP (SR)	10 Asbestos-cement
2 Brass	4 Galvanized steel	6 Concrete tile	9 ABS	11 Other (specify)
				12 None used (open hole)

SCREEN OR PERFORATION OPENINGS ARE:

1 Continuous slot	3 Mill slot	5 Gauzed wrapped	8 Saw cut	11 None (open hole)
2 Louvered shutter	4 Key punched	6 Wire wrapped	9 Drilled holes	
		7 Torch cut	10 Other (specify) Bridge Slot	

SCREEN-PERFORATED INTERVALS: From 57 ft. to 77 ft., From ft. to ft.

GRAVEL PACK INTERVALS: From 21 ft. to 78 ft., From ft. to ft.

6 GROUT MATERIAL: 1 Neat cement 2 Cement grout 3 Bentonite 4 Other

Grout Intervals: From 0 ft. to 21 ft., From ft. to ft.

What is the nearest source of possible contamination:

1 Septic tank	4 Lateral lines	7 Pit privy	10 Livestock pens	14 Abandoned water well
2 Sewer lines	5 Cess pool	8 Sewage lagoon	11 Fuel storage	15 Oil well/Gas well
3 Watertight sewer lines	6 Seepage pit	9 Feedyard	12 Fertilizer storage	16 Other (specify below)
			13 Insecticide storage	None known

How many feet?

Direction from well?

FROM	TO	LITHOLOGIC LOG	FROM	TO	PLUGGING INTERVALS
0	4	Topsoil			
4	12	Clay, brown			
12	15	Sand, very fine with clay			
15	37	Clay, brown, hard			
37	45	Sand nad gravel, fine, medium			
45	77	Sand and gravel, fine, medium, coarse			
77	78	Clay, white			

7 CONTRACTOR'S OR LANDOWNER'S CERTIFICATION: This water well was (1) constructed, (2) reconstructed, or (3) plugged under my jurisdiction and was completed on (mo/day/year) 5-11-99 and this record is true to the best of my knowledge and belief. Kansas Water Well Contractor's License No. 185 This Water Well Record was completed on (mo/day/yr) 5-13-99 under the business name of Clarke Well & Equipment, Inc. by (signature) *Conrad W. Clarke*

INSTRUCTIONS: Use typewriter or ball point pen. PLEASE PRESS FIRMLY and PRINT clearly. Please fill in blanks, underline or circle the correct answers. Send top three copies to Kansas Department of Health and Environment, Bureau of Water, Topeka, Kansas 66620-0001. Telephone: 913-296-5545. Send one to WATER WELL OWNER and retain one for your records.