


1 LOCATION OF WATER WELL: County: PRATT Fraction NC-ES 1/4 SE 1/4 1/4 Section Number 13 Township Number T 26 S Range Number R 12 EW

Distance and direction from nearest town or city street address of well if located within city?
1 Mile North, 1 Mile West - 1/4 Mile North Of Preston, Kns.

2 WATER WELL OWNER: Velma Henrichs
RR#, St. Address, Box #: 615 Circle Drive Board of Agriculture, Division of Water Resources
City, State, ZIP Code: Wellington, Kans. = ~~67122~~ 67152 Application Number: #43,253

3 LOCATE WELL'S LOCATION WITH AN "X" IN SECTION BOX:

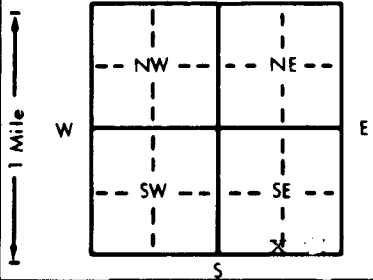

4 DEPTH OF COMPLETED WELL: 170 ft. ELEVATION:

Depth(s) Groundwater Encountered 1. 31' ft. 2. ft. 3. ft.
WELL'S STATIC WATER LEVEL ... 29 ft. below land surface measured on mo/day/yr Nov. 12, 1999.
Pump test data: Well water was ... ft. after ... hours pumping ... gpm
Est. Yield Test Well water was ... ft. after ... hours pumping ... gpm
Bore Hole Diameter ... 6 3/4 in. 170 ft., and ... in. to ... ft.
WELL WATER TO BE USED AS: 5 Public water supply 8 Air conditioning 11 Injection well
1 Domestic 3 Feedlot 6 Oil field water supply 9 Dewatering 12 Other (Specify below)
2 Irrigation ~~XX~~ 4 Industrial 7 Lawn and garden only 10 Monitoring well
Was a chemical/bacteriological sample submitted to Department? Yes ... No ... ~~XX~~; If yes, mo/day/yr sample was submitted Water Well Disinfected? Yes No ~~XX~~

5 TYPE OF BLANK CASING USED: SCH, 80 5 Wrought iron 8 Concrete tile CASING JOINTS: Glued ~~XX~~ Clamped
1 Steel 3 RMP (SR) 6 Asbestos-Cement 9 Other (specify below) Welded
2 PVC ~~XX~~ 4 ABS 7 Fiberglass Threaded

Blank casing diameter ... 3 in. to ... 155 ft., Dia ... in. to ... ft., Dia ... in. to ... ft.
Casing height above land surface ... 2 in., weight ... 1.956 lbs./ft. Wall thickness or gauge No. 3.00

TYPE OF SCREEN OR PERFORATION MATERIAL: 7 PVC ~~X~~ 10 Asbestos-cement
1 Steel 3 Stainless steel 5 Fiberglass 8 RMP (SR) 11 Other (specify)
2 Brass 4 Galvanized steel 6 Concrete tile 9 ABS 12 None used (open hole)

SCREEN OR PERFORATION OPENINGS ARE: 5 Gauzed wrapped 8 Saw cut ~~XX~~ 11 None (open hole)
1 Continuous slot 3 Mill slot 6 Wire wrapped 9 Drilled holes
2 Louvered shutter 4 Key punched 7 Torch cut 10 Other (specify)

SCREEN-PERFORATED INTERVALS: From ... 170' ft. to ... 164' ft., From ... ft. to ... ft.
GRAVEL PACK INTERVALS: From ... 170 ft. to ... 155' ft., From ... ft. to ... ft.

6 GROUT MATERIAL: 1 Neat cement 2 Cement grout ~~XX~~ 3 Bentonite 4 Other
Grout Intervals: From ... 155' ft. to ... 2' ft., From ... ft. to ... ft., From ... ft. to ... ft.

What is the nearest source of possible contamination:
1 Septic tank 4 Lateral lines 7 Pit privy 10 Livestock pens 14 Abandoned water well
2 Sewer lines 5 Cess pool 8 Sewage lagoon 11 Fuel storage ~~XX~~ 15 Oil well/Gas well
3 Watertight sewer lines 6 Seepage pit 9 Feedyard 12 Fertilizer storage 16 Other (specify below)
13 Insecticide storage
Direction from well? South West How many feet? APP 2640'

FROM	TO	LITHOLOGIC LOG	FROM	TO	
00	2'	Top Soil	113'	115'	Soft Brown Clay.
2'	6'	Silty Sand.	115'	139'	Medium Course Sand & Gravel.
6'	12'	Very Fine Sand.	139'	141'	Brown Clay.
12'	22'	Fine Sand/Clay Strip.	141'	155'	Medium Course Sand & Gravel.
21'	22'	Fine Sand.	155'	165'	Medium Fine Sand W/Red Streaks
22'	24'	Fine Sand.	165'	170'	Sand Stones, Very Hard (Red).
24'	31'	Fine Sand.			
31'	35'	Fine Sand W/Fine Gravel.			
35'	50'	Fine Sand & Gravel.			
50'	54'	Medium Course Sand - /51' Hard Streak			
54'	55'	Yellow Clay.			
55'	66'	Tan Clay.			
66'	84'	Course Sand & Fine Gravel.			
84'	86'	Sand & gravel W/Clay.			
86'	113'	Course Sand & Gfavel.			

7 CONTRACTOR'S OR LANDOWNER'S CERTIFICATION: This water well was (1) constructed, (2) reconstructed, or (3) plugged under my jurisdiction and was completed on (mo/day/year) ... Nov. 12, 1999 ... and this record is true to the best of my knowledge and belief. Kansas Water Well Contractor's License No. 112 This Water Well Record was completed on (mo/day/yr) Dec. 6, 1999 under the business name of Wells Drilling Co. by (signature) *Sal Wells*

OFFICE USE ONLY
T
R
EW
SEC.
1/4
1/4
1/4