


1 LOCATION OF WATER WELL: Fraction Section Number Township Number Range Number
 County: Pratt NE 1/4 NE 1/4 SE 1/4 13 T 26 S R 12W ~~XX~~ ~~EWK~~

Distance and direction from nearest town or city street address of well if located within city?
1 Mile North, 1 Mile West, 1/2 Mile North Of Preston, Kns

2 WATER WELL OWNER: Morgan Trinkle
 RR#, St. Address, Box # : *8636NE 70 th St. Board of Agriculture, Division of Water Resources
 City, State, ZIP Code : Preston, Kansas 67569 Application Number:

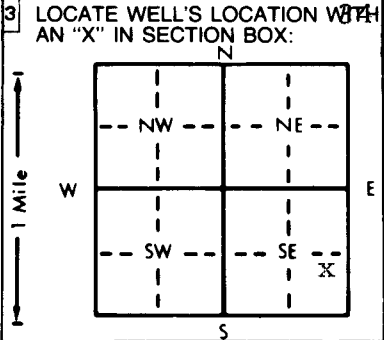

4 DEPTH OF COMPLETED WELL... 151... ft. ELEVATION:
 Depth(s) Groundwater Encountered 1. 34' ft. 2. ft. 3. ft.
 WELL'S STATIC WATER LEVEL 34' ft. below land surface measured on mo/day/yr Nov. 26-2001
 Pump test data: Well water was ft. after hours pumping gpm
 Est. Yield 900 gpm: Well water was ft. after hours pumping gpm
 Bore Hole Diameter... 28" in. to 151' ft., and in. to ft.
 WELL WATER TO BE USED AS: 5 Public water supply 8 Air conditioning 11 Injection well
 1 Domestic 3 Feedlot 6 Oil field water supply 9 Dewatering 12 Other (Specify below)
~~XX~~ Irrigation 4 Industrial 7 Lawn and garden only 10 Monitoring well
 Was a chemical/bacteriological sample submitted to Department? Yes.....No.....~~XX~~.....; If yes, mo/day/yr sample was submitted
 Water Well Disinfected? Yes No ~~XX~~

5 TYPE OF BLANK CASING USED: 5 Wrought iron 8 Concrete tile CASING JOINTS: Glued ~~XX~~ Clamped
 1 Steel 3 RMP (SR) 6 Asbestos-Cement 9 Other (specify below) Welded
 2 PVC ~~XX~~ 4 ABS 7 Fiberglass Threaded
 Blank casing diameter 16" in. to 91' ft., Dia in. to ft., Dia in. to ft.
 Casing height above land surface... 12" in., weight 1592 lbs./ft. Wall thickness or gauge No. 500
 TYPE OF SCREEN OR PERFORATION MATERIAL: 7 PVC ~~XX~~ 10 Asbestos-cement
 1 Steel 3 Stainless steel 5 Fiberglass 8 RMP (SR) 11 Other (specify)
 2 Brass 4 Galvanized steel 6 Concrete tile 9 ABS 12 None used (open hole)
 SCREEN OR PERFORATION OPENINGS ARE: 5 Gauzed wrapped 8 Saw cut 11 None (open hole)
 1 Continuous slot 3 Mill slot ~~XX~~ 6 Wire wrapped 9 Drilled holes
 2 Louvered shutter 4 Key punched 7 Torch cut 10 Other (specify)
 SCREEN-PERFORATED INTERVALS: From 151 ft. to 91' ft., From ft. to ft.
 From ft. to ft., From ft. to ft.
 GRAVEL PACK INTERVALS: From 151' ft. to 23' ft., From ft. to ft.
 From ft. to ft., From ft. to ft.

6 GROUT MATERIAL: 1 Neat cement ~~XX~~ Cement grout 3 Bentonite 4 Other
 Grout Intervals: From 23 ft. to 0 ft., From ft. to ft., From ft. to ft.
 What is the nearest source of possible contamination: 10 Livestock pens 14 Abandoned water well
 1 Septic tank 4 Lateral lines 7 Pit privy 11 Fuel storage 15 Oil well/Gas well ~~XX~~
 2 Sewer lines 5 Cess pool 8 Sewage lagoon 12 Fertilizer storage 16 Other (specify below)
 3 Watertight sewer lines 6 Seepage pit 9 Feedyard 13 Insecticide storage
 Direction from well? South How many feet? APP: 2640'

FROM	TO	LITHOLOGIC LOG	FROM	TO	PLUGGING INTERVALS
0'	3'	Top Soil.			
3'	11'	Brown Clay.			
11'	32'	ClayW/ Fine Sand.			
32'	48'	Medium Fine Sand (Cemented).			
48'	55'	Medium Course & Gravel.			
55'	65'	Grey Clay.			
65'	88'	Course Sand.			
88'	112'	Course Sand & Gravel.			
112'	116'	Clay.			
116'	151'	Course Sand & Gravel.			
		Hard Clay.			

7 CONTRACTOR'S OR LANDOWNER'S CERTIFICATION: This water well was (1) constructed, (2) reconstructed, or (3) plugged under my jurisdiction and was completed on (mo/day/year) Nov. 12-2001 and this record is true to the best of my knowledge and belief. Kansas Water Well Contractor's License No. 112 This Water Well Record was completed on (mo/day/yr) Dec 6-2001 under the business name of Wells Drilling Co. by (signature) Wells

INSTRUCTIONS: Use typewriter or ball point pen. PLEASE PRESS FIRMLY and PRINT clearly. Please fill in blanks, underline or circle the correct answers. Send top three copies to Kansas Department of Health and Environment, Bureau of Water, Topeka, Kansas 66620-0001. Telephone: 913-296-5545. Send one to WATER WELL OWNER and retain one for your records.

OFFICE USE ONLY
T
R
EW
SEC
1/4
1/4
1/4