


WATER WELL RECORD Form WWC-5 KSA 82a-1212

1 LOCATION OF WATER WELL: County: <u>Pratt</u>	Fraction <u>1/4 N/C 1/4 NE 1/4</u>	Section Number <u>4</u>	Township Number <u>T 26 S</u>	Range Number <u>R 12 EW</u>
---------------------------------------------------	---------------------------------------	----------------------------	----------------------------------	--------------------------------

Distance and direction from nearest town or city street address of well if located within city?
4 miles north, 3 3/4 west of Preston, Ks.

2 WATER WELL OWNER: Warren Hatzenbuehler
 RR#, St. Address, Box # : 80248 N. Hwy. 281
 City, State, ZIP Code : Iuka, Ks. 67066

Board of Agriculture, Division of Water Resources
 Application Number: _____

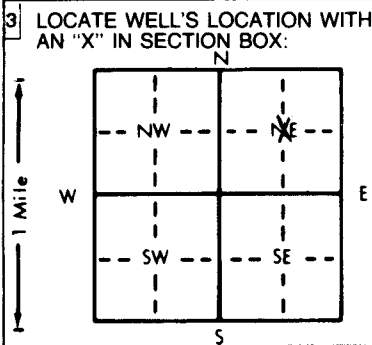

4 DEPTH OF COMPLETED WELL: 130 1/2 ft. ELEVATION: _____

Depth(s) Groundwater Encountered 1. _____ ft. 2. _____ ft. 3. _____ ft.

WELL'S STATIC WATER LEVEL: 20 ft. below land surface measured on mo/day/yr 3-3-98

Pump test data: Well water was _____ ft. after _____ hours pumping _____ gpm
 Est. Yield na gpm: Well water was _____ ft. after _____ hours pumping _____ gpm

Bore Hole Diameter: 5 1/2 in. to 130 1/2 ft., and _____ in. to _____ ft.

WELL WATER TO BE USED AS:
 5 Public water supply 8 Air conditioning 11 Injection well
 1 Domestic 3 Feedlot 6 Oil field water supply 9 Dewatering 12 Other (Specify below)
 2 Irrigation 4 Industrial 7 Lawn and garden only 10 Monitoring well

Was a chemical/bacteriological sample submitted to Department? Yes X No _____; If yes, mo/day/yr sample was submitted _____
 Water Well Disinfected? Yes _____ No X

5 TYPE OF CASING USED:
 1 Steel 3 RMP (SR) 5 Wrought iron 8 Concrete tile CASING JOINTS: Glued X Clamped _____
 2 PVC 4 ABS 6 Asbestos-Cement 9 Other (specify below) Welded _____
 7 Fiberglass _____ Threaded _____

Blank casing diameter: 2 1/2 in. to 3 3/2 ft. X Dia 125 1/2 in. to _____ ft., Dia _____ in. to _____ ft.
 Casing height above land surface: 2 in., weight SDR 26 lbs./ft. Wall thickness or gauge No. _____

TYPE OF SCREEN OR PERFORATION MATERIAL:
 1 Steel 3 Stainless steel 5 Fiberglass 8 RMP (SR) 10 Asbestos-cement
 2 Brass 4 Galvanized steel 6 Concrete tile 9 ABS 11 Other (specify) _____
 12 None used (open hole)

SCREEN OR PERFORATION OPENINGS ARE:
 1 Continuous slot 3 Mill slot 5 Gauzed wrapped 8 Saw cut 11 None (open hole)
 2 Louvered shutter 4 Key punched 6 Wire wrapped 9 Drilled holes
 7 Torch cut 10 Other (specify) _____

SCREEN-PERFORATED INTERVALS: From 125 1/2 ft. to 130 1/2 ft., From _____ ft. to _____ ft.
 From _____ ft. to _____ ft., From _____ ft. to _____ ft.

GRAVEL PACK INTERVALS: From 130 1/2 ft. to 20 ft., From _____ ft. to _____ ft.
 From _____ ft. to _____ ft., From _____ ft. to _____ ft.

6 GROUT MATERIAL: 1 Neat cement 2 Cement grout 3 Bentonite 4 Other hole plug

Grout Intervals: From 20 ft. to 0 ft., From _____ ft. to _____ ft.

What is the nearest source of possible contamination:
 1 Septic tank 4 Lateral lines 7 Pit privy 10 Livestock pens 14 Abandoned water well
 2 Sewer lines 5 Cess pool 8 Sewage lagoon 11 Fuel storage 15 Oil well/Gas well
 3 Watertight sewer lines 6 Seepage pit 9 Feedyard 12 Fertilizer storage 16 Other (specify below)
 13 Insecticide storage _____

Direction from well? West How many feet? 100'

FROM	TO	LITHOLOGIC LOG	FROM	TO	PLUGGING INTERVALS
0	<u>2 1/2</u>	<u>Sandy top soil</u>			
<u>2 1/2</u>	<u>6</u>	<u>Tough brown clay</u>			
<u>6</u>	<u>25</u>	<u>Bkrown & white clay</u>			
<u>25</u>	<u>33</u>	<u>Sand and gravel</u>			
<u>33</u>	<u>36</u>	<u>Brown clay</u>			
<u>36</u>	<u>57</u>	<u>Sand and gravel clean, coarse & loose</u>			
<u>57</u>	<u>64</u>	<u>Brown & white clay</u>			
<u>64</u>	<u>71</u>	<u>Sand and gravel</u>			
<u>71</u>	<u>85</u>	<u>Brown, white, gray clay, lot of caliche</u>			
<u>85</u>	<u>130</u>	<u>Sand and gravel clean, coarse, & loose</u>			
<u>130</u>	<u>130 1/2</u>	<u>Gray clay</u>			

7 CONTRACTOR'S OR LANDOWNER'S CERTIFICATION: This water well was (1) constructed, (2) reconstructed, or (3) plugged under my jurisdiction and was completed on (mo/day/year) 3-3-98 and this record is true to the best of my knowledge and belief. Kansas Water Well Contractor's License No. 134 This Water Well Record was completed on (mo/day/yr) 3-5-98 under the business name of Rosencrantz-Bemis by (signature) Fredia Hedson

OFFICE USE ONLY
T
R
EW
SEC.