


#1
SE Monitoring Well

WATER WELL RECORD Form WWC-5 KSA 82a-1212

1 LOCATION OF WATER WELL: Fraction SW 1/4 SW 1/4 NW 1/4 Section Number 33 Township Number T 26 S Range Number R 12 SW
 County: Pratt
 Distance and direction from nearest town or city street address of well if located within city?
1 Mile South, 6 Miles West, 3/8 Mile South Of Preston, Kans.

2 WATER WELL OWNER: Geraldine GREEN.
 RR#, St. Address, Box # : 1102 Myrtle Board of Agriculture, Division of Water Resources
 City, State, ZIP Code : Pratt, Kans. 67124 Application Number:

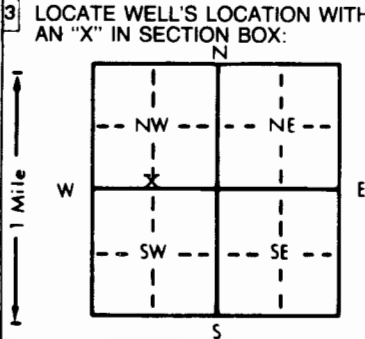

4 DEPTH OF COMPLETED WELL: 106' ELEVATION:
 Depth(s) Groundwater Encountered 1. 29' ft. 2. ft. 3. ft.
 WELL'S STATIC WATER LEVEL 29' ft. below land surface measured on mo/day/yr
 Pump test data: Well water was ft. after hours pumping gpm
 Est. Yield NA gpm: Well water was ft. after hours pumping gpm
 Bore Hole Diameter 6 3/4" to 106' ft., and in. to in.
 WELL WATER TO BE USED AS:
 5 Public water supply 8 Air conditioning 11 Injection well
 1 Domestic 3 Feedlot 6 Oil field water supply 9 Dewatering 12 Other (Specify below)
 2 Irrigation 4 Industrial 7 Lawn and garden only 10 Monitoring well xx
 Was a chemical/bacteriological sample submitted to Department? Yes No X If yes, mo/day/yr sample was submitted
 Water Well Disinfected? Yes No X

5 TYPE OF BLANK CASING USED:
 1 Steel 3 RMP (SR) 5 Wrought iron 8 Concrete tile CASING JOINTS: Glued xx Clamped
 2 PVC xx 4 ABS 6 Asbestos-Cement 9 Other (specify below) Welded
 7 Fiberglass Threaded
 Blank casing diameter 3" in. to 106' ft., Dia in. to in. Dia in. to in.
 Casing height above land surface 24" in., weight 1.956 lbs./ft. Wall thickness or gauge No. .80
 TYPE OF SCREEN OR PERFORATION MATERIAL:
 1 Steel 3 Stainless steel 5 Fiberglass x7 PVC 10 Asbestos-cement
 2 Brass 4 Galvanized steel 6 Concrete tile 9 ABS 11 Other (specify)
 12 None used (open hole)
 SCREEN OR PERFORATION OPENINGS ARE:
 1 Continuous slot 3 Mill slot 5 Gauzed wrapped 8 Saw cut xx 11 None (open hole)
 2 Louvered shutter 4 Key punched 6 Wire wrapped 9 Drilled holes
 7 Torch cut 10 Other (specify)
 SCREEN-PERFORATED INTERVALS: From 101' ft. to 106' ft., From ft. to ft.
 From ft. to ft., From ft. to ft.
 GRAVEL PACK INTERVALS: From ft. to ft., From ft. to ft.
 From 21' ft. to 106' ft., From ft. to ft.

6 GROUT MATERIAL: 1 Neat cement 2 Cement grout xx3 Bentonite 4 Other
 Grout Intervals: From 21' ft. to 0' ft., From ft. to ft., From ft. to ft.
 What is the nearest source of possible contamination:
 1 Septic tank 4 Lateral lines 7 Pit privy 10 Livestock pens 14 Abandoned water well
 2 Sewer lines 5 Cess pool 8 Sewage lagoon 11 Fuel storage xx Oil well/Gas well
 3 Watertight sewer lines 6 Seepage pit 9 Feedyard 12 Fertilizer storage 16 Other (specify below)
 13 Insecticide storage
 Direction from well? SW How many feet? APP: 1200'

FROM	TO	LITHOLOGIC LOG	FROM	TO	PLUGGING INTERVALS
0'	15'	Top Soil (Clay).			
15'	20'	Sand & Gravel.			
20'	27'	Sand & Gravel.			
27'	29'	Clay.			
29'	51'	Course Sand.			
51'	71'	Clay.			
71'	106'	Course Sand & Fine Gravel.			
106'	107'	White Clay.			

7 CONTRACTOR'S OR LANDOWNER'S CERTIFICATION: This water well was (1) constructed, (2) reconstructed, or (3) plugged under my jurisdiction and was completed on (mo/day/year) Mar. 3 1998 and this record is true to the best of my knowledge and belief. Kansas Water Well Contractor's License No. 112 This Water Well Record was completed on (mo/day/yr) May 30 1998 under the business name of WELLS DRILLING CO. by (signature) Dal Wells

INSTRUCTIONS: Use typewriter or ball point pen. PLEASE PRESS FIRMLY and PRINT clearly. Please fill in blanks, underline or circle the correct answers. Send top three copies to Kansas Department of Health and Environment, Bureau of Water, Topeka, Kansas 66620-0001. Telephone: 913-296-5545. Send one to WATER WELL OWNER and retain one for your records.

OFFICE USE ONLY
T
R
EW
SEC.
1/4
1/4
1/4