

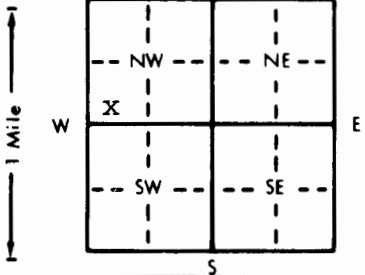
WATER WELL RECORD Form WWC-5 KSA 82a-1212

1 LOCATION OF WATER WELL: County: PRATT	Fraction SW ¼ SW ¼ SW ¼	Section Number 33	Township Number T 26 S	Range Number R 12 E/W
--	----------------------------	----------------------	---------------------------	--------------------------

Distance and direction from nearest town or city street address of well if located within city?

1 Mile South, 6 Miles West 'm 3/8 Mile, South Of Preston, Kans.

2 WATER WELL OWNER: Geraldine GREEN RR#, St. Address, Box #: 1102 Mrytle City, State, ZIP Code: Pratt, Kans.	Board of Agriculture, Division of Water Resources Application Number:
--	--

3 LOCATE WELL'S LOCATION WITH AN "X" IN SECTION BOX: 	4 DEPTH OF COMPLETED WELL: 126' ft. ELEVATION: Depth(s) Groundwater Encountered 1. 44' ft. 2. ft. 3. ft. WELL'S STATIC WATER LEVEL 44' ft. below land surface measured on mo/day/yr April 12 1998 Pump test data: Well water was ft. after hours pumping gm Est. Yield NA gpm: Well water was ft. after hours pumping gm Bore Hole Diameter 6 3/4" in. to 126' ft., and in. to ft. WELL WATER TO BE USED AS: 5 Public water supply 8 Air conditioning 11 Injection well 1 Domestic 3 Feedlot 6 Oil field water supply 9 Dewatering 12 Other (Specify below) 2 Irrigation 4 Industrial 7 Lawn and garden only 10 Monitoring well XX Was a chemical/bacteriological sample submitted to Department? Yes No X; If yes, mo/day/yr sample was submitted Water Well Disinfected? Yes No X
--	--

5 TYPE OF BLANK CASING USED: 1 Steel 3 RMP (SR) 2 PVC XX 4 ABS Blank casing diameter 3" in. to 106' ft., Dia in. to ft., Dia in. to ft. Casing height above land surface 24" in., weight 1.956 lbs./ft. Wall thickness or gauge No. # 80 TYPE OF SCREEN OR PERFORATION MATERIAL: 1 Steel 3 Stainless steel 5 Fiberglass 8 RMP (SR) 10 Asbestos-cement 2 Brass 4 Galvanized steel 6 Concrete tile 9 ABS 11 Other (specify) 12 None used (open hole) SCREEN OR PERFORATION OPENINGS ARE: 1 Continuous slot 3 Mill slot 5 Gauzed wrapped XX Saw cut 11 None (open hole) 2 Louvered shutter 4 Key punched 6 Wire wrapped 9 Drilled holes 7 Torch cut 10 Other (specify) SCREEN-PERFORATED INTERVALS: From 106' ft. to 111' ft., From ft. to ft. From ft. to ft., From ft. to ft. GRAVEL PACK INTERVALS: From 126' ft. to 22' ft., From ft. to ft. From ft. to ft., From ft. to ft.	CASING JOINTS: Glued XX Clamped Welded Threaded
--	---

6 GROUT MATERIAL: 1 Neat cement 2 Cement grout XX Bentonite 4 Other Grout Intervals: From 22' ft. to 0' ft., From ft. to ft., From ft. to ft. What is the nearest source of possible contamination: 1 Septic tank 4 Lateral lines 7 Pit privy 10 Livestock pens 14 Abandoned water well 2 Sewer lines 5 Cess pool 8 Sewage lagoon 11 Fuel storage XX Oil well/Gas well 3 Watertight sewer lines 6 Seepage pit 9 Feedyard 12 Fertilizer storage 16 Other (specify below) 13 Insecticide storage Direction from well? SW How many feet? APP: 1200'
--

FROM	TO	LITHOLOGIC LOG	FROM	TO	PLUGGING INTERVALS
0'	12'	Clay.			
12'	36'	Sand & Gravel.			
36'	44'	Clay.			
44'	53'	Sand & Gravel.			
53'	73'	Clay.			
73'	111'	Course Sand & Fine Gravel.			
111'	126'	Clay.			

7 CONTRACTOR'S OR LANDOWNER'S CERTIFICATION: This water well was (1) constructed, (2) reconstructed, or (3) plugged under my jurisdiction and was completed on (mo/day/year) Mar. 3 1998 and this record is true to the best of my knowledge and belief. Kansas Water Well Contractor's License No. 112 This Water Well Record was completed on (mo/day/yr) May 30 1998 under the business name of WELLS DRILLING CO by (signature) Dal Wells

OFFICE USE ONLY
T
R
EM
SEC.
1/4
1/4
1/4