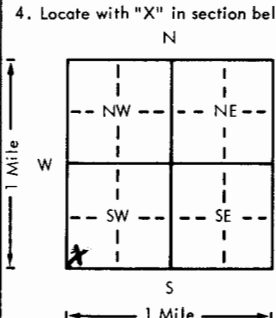


USE TYPEWRITER OR BALL POINT PEN-PRESS FIRMLY, PRINT CLEARLY.

WATER WELL RECORD
KSA 82a-1201-1215

Kansas Department of Health and Environment-Division of Environment
(Water well Contractors)
Topeka, Kansas 66620

1. Location of well:		County Pratt	Fraction SW 1/4 SW 1/4 SW 1/4	Section number 1	Township number T 26 S R 2E	Range number 12 E/W
2. Distance and direction from nearest town or city: Street address of well location if in city: 3N 2W Preston				3. Owner of well: John Gatz R.R. or street: City, state, zip code: Preston, Kansas 67569		
4. Locate with "X" in section below: 				Sketch map: <i>Pond</i> <i>Lateral</i> <input checked="" type="checkbox"/> <i>Septic</i> <i>Horse well</i>		
5. Type and color of material				From	To	
earth				0	5	
brown clay				5	20	
brown fine sandy clay				20	35	
brown clay				35	42	
fine sand brown				42	52	
sand brown				52	59	
sand & gravel				59	69	
(Use a second sheet if needed)						
18. Elevation: level Topography: <input type="checkbox"/> Hill <input type="checkbox"/> Slope <input type="checkbox"/> Upland <input type="checkbox"/> Valley	19. Remarks: this is flat land with surface water hole NW approx. 800'			6. Bore hole dia. 10 in. Completion date 5-1-80 Well depth 69 ft.		
				7. <input type="checkbox"/> Cable tool <input checked="" type="checkbox"/> Rotary <input type="checkbox"/> Driven <input type="checkbox"/> Dug <input type="checkbox"/> Hollow rod <input type="checkbox"/> Jetted <input type="checkbox"/> Bored <input type="checkbox"/> Reverse rotary		
				8. Use: <input checked="" type="checkbox"/> Domestic <input type="checkbox"/> Public supply <input type="checkbox"/> Industry <input type="checkbox"/> Irrigation <input type="checkbox"/> Air conditioning <input type="checkbox"/> Stock <input type="checkbox"/> Lawn <input type="checkbox"/> Oil field water <input type="checkbox"/> Other		
				9. Casing: Material pvc Height: Above or below Threaded <input type="checkbox"/> Welded <input checked="" type="checkbox"/> Surface 12 in. RMP <input type="checkbox"/> PVC <input checked="" type="checkbox"/> Weight 160 250 lbs/ft. Dia. 5 in. to 66 ft. depth Wall Thickness: inches or Dia. 5 in. to 66 ft. depth Gage No. sch 40		
				10. Screen: Manufacturer's name Pumpco Type pvc Dia. 5" Slot/gauze 1/16 Length 10' Set between 59 ft. and 69 ft. ft. and 69 ft. Gravel pack? yes Size range of material 1/16 to 3/8		
				11. Static water level: _____ mo./day/yr. 33 ft. below land surface Date 5-1-80		
				12. Pumping level below land surfaces: _____ ft. after _____ hrs. pumping _____ g.p.m. _____ ft. after _____ hrs. pumping _____ g.p.m. Estimated maximum yield 50 g.p.m.		
				13. Water sample submitted: _____ mo./day/yr. <input type="checkbox"/> Yes <input checked="" type="checkbox"/> No Date _____		
				14. Well head completion: <input checked="" type="checkbox"/> Pitless adapter 11 inches above grade		
				15. Well grouted? yes With: <input checked="" type="checkbox"/> Neat cement <input type="checkbox"/> Bentonite <input type="checkbox"/> Concrete Depth: From 4'6" ft. to 14'6"		
				16. Nearest source of possible contamination: ft. 50 Direction N Type Septic Well disinfected upon completion? <input checked="" type="checkbox"/> Yes <input type="checkbox"/> No		
				17. Pump: _____ Not installed Manufacturer's name Pumpco Model number 152857 HP 1/2 Volts 230 Length of drop pipe 35 ft. capacity 15 g.p.m. Type: <input checked="" type="checkbox"/> Submersible <input type="checkbox"/> Turbine <input type="checkbox"/> Jet <input type="checkbox"/> Reciprocating <input type="checkbox"/> Centrifugal <input type="checkbox"/> Other		
				20. Water well contractor's certification: This well was drilled under my jurisdiction and this report is true to the best of my knowledge and belief. Hank Bruse W.W.Serv. 103 Business name 1117 Stout License No. _____ Address _____ Signed <i>Hank Bruse</i> Date 5-1-80 Authorized representative		

Forward the white, blue and pink copies to the Department of Health and Environment

Form WWC-5