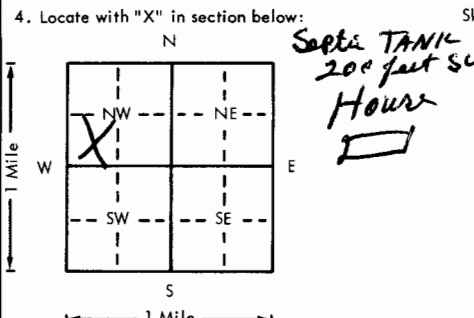


USE TYPEWRITER OR BALL POINT PEN-PRESS FIRMLY, PRINT CLEARLY.

WATER WELL RECORD  
KSA 82a-1201-1215

Kansas Department of Health and Environment  
Division of Environment  
(Water well Contractors)  
Topeka, Kansas 66620

1. Location of well: County <b>Pratt</b>		Fraction <b>NW 1/4</b> C 1/4 1/4 1/4		Section number <b>9</b>	Township number <b>26</b> T 26 S R 12 E 10	Range number <b>12</b>
2. Distance and direction from nearest town or city: <b>2 1/2 north 5 West of Pratt, 1 km</b> Street address of well location if in city:				3. Owner of well: <b>Vergil Biggeman</b> R.R. or street: <b>RR 1</b> City, state, zip code: <b>Pratt</b>		
4. Locate with "X" in section below: Sketch map:  Septic Tank 200 feet SW Hours Well House X				6. Bore hole dia. <b>8</b> in. Completion date <b>5-15 78</b> Well depth <b>70</b> ft.		
5. Type and color of material				7. <input type="checkbox"/> Cable tool <input checked="" type="checkbox"/> Rotary <input type="checkbox"/> Driven <input type="checkbox"/> Dug <input type="checkbox"/> Hollow rod <input type="checkbox"/> Jetted <input type="checkbox"/> Bored <input type="checkbox"/> Reverse rotary		
				8. Use: <input checked="" type="checkbox"/> Domestic <input type="checkbox"/> Public supply <input type="checkbox"/> Industry <input type="checkbox"/> Irrigation <input type="checkbox"/> Air conditioning <input type="checkbox"/> Stock <input type="checkbox"/> Lawn <input type="checkbox"/> Oil field water <input type="checkbox"/> Other		
				9. Casing: Material <b>PVC</b> Height: <b>Above</b> below Threaded <input type="checkbox"/> Welded <input type="checkbox"/> Surface <b>24"</b> in. RMP <input type="checkbox"/> PVC <input type="checkbox"/> Weight <input type="checkbox"/> lbs./ft. Dia. <input type="checkbox"/> in. to <input type="checkbox"/> ft. depth Wall Thickness: inches or Dia. <input type="checkbox"/> in. to <input type="checkbox"/> ft. depth gage No. <b>44</b>		
				10. Screen: Manufacturer's name <b>Jim &amp; Lowell</b> Type <b>PLATE</b> Dia. <b>5</b> Slot/gauze <b>1/4</b> Length <b>20</b> Set between <b>50</b> ft. and <b>70</b> ft. <input type="checkbox"/> ft. and <input type="checkbox"/> ft. Gravel pack? <input checked="" type="checkbox"/> Size range of material <b>1/4</b>		
				11. Static water level: <input type="checkbox"/> mo./day/yr. <b>30</b> ft. below land surface Date <b>5/15/78</b>		
				12. Pumping level below land surfaces: <input type="checkbox"/> ft. after <input type="checkbox"/> hrs. pumping <input type="checkbox"/> g.p.m. <input type="checkbox"/> ft. after <input type="checkbox"/> hrs. pumping <input type="checkbox"/> g.p.m. Estimated maximum yield <input type="checkbox"/> g.p.m.		
				13. Water sample submitted: <input type="checkbox"/> mo./day/yr. <input type="checkbox"/> Yes <input checked="" type="checkbox"/> No Date <b>5/15/78</b>		
				14. Well head completion: <b>Well House</b> <input type="checkbox"/> Pitless adapter <b>24</b> inches above grade		
				15. Well grouted? <input checked="" type="checkbox"/> With: <input checked="" type="checkbox"/> Neat cement <input type="checkbox"/> Bentonite <input type="checkbox"/> Concrete Depth: From <b>1</b> ft. to <b>10</b> ft.		
				16. Nearest source of possible contamination: ft. <b>200</b> Direction <b>SW</b> Type <b>Human</b> Well disinfected upon completion? <input checked="" type="checkbox"/> Yes <input type="checkbox"/> No		
				17. Pump: <input type="checkbox"/> Not installed Manufacturer's name _____ Model number _____ HP _____ Volts _____ Length of drop pipe _____ ft. capacity _____ g.p.m. Type: <input type="checkbox"/> Submersible <b>Not installed by me</b> Turbine <input type="checkbox"/> Jet _____ Reciprocating <input type="checkbox"/> Centrifugal _____ Other _____		
(Use a second sheet if needed)						
18. Elevation:  Topography: <input type="checkbox"/> Hill <input checked="" type="checkbox"/> Slope <input type="checkbox"/> Upland <input type="checkbox"/> Valley		19. Remarks:  <b>Concrete slab to be installed by customer and Well House 4x4 slab</b>		20. Water well contractor's certification: This well was drilled under my jurisdiction and this report is true to the best of my knowledge and belief. <b>Walter Upell Senior 226</b> Business name _____ License No. _____ Address <b>Leon G. Upell</b> Signed <b>Leon G. Upell</b> Date <b>5/15/78</b> Authorized representative		

78  
26-120-9  
T  
R  
Sec  
1/4  
1/4  
1/4  
C NW