USE TYPEWRITER OR BALL POINT PEN-PRESS FIRMLY, PRINT CLEARLY.

WATER WELL RECORD
KSA 82a-1201-1215

Kansas Department of Health and Environment-Division of Environment
(Water well Contractors)
Topeka, Kansas 66620

1. Location of well:	County	Fraction	Section number	Township number	Range number
	Pratt	NW 1/4 SE 1/4 NW 1/4	11	T 26 S	R 12 E/W

2. Distance and direction from nearest town or city:
From Preston, Ks 3mi North 3mi West
Street address of well location if in city:
1/2 mi South - East into field

3. Owner of well: B&B Drilling Co.
R.R. or street: 515 Union Center
City, state, zip code: Wichita, Kansas 67202

4. Locate with "X" in section below: Sketch map:

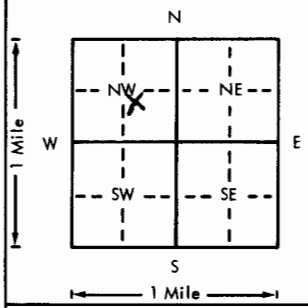

6. Bore hole dia. 11 in. Completion date
Well depth 150 ft. 6-21-77

7. __ Cable tool X Rotary __ Driven __ Dug
__ Hollow rod __ Jetted __ Bored __ Reverse rotary

8. Use: __ Domestic __ Public supply X Industry
__ Irrigation __ Air conditioning __ Stock
__ Lawn __ Oil field water __ Other

9. Casing: Material pvc Height: Above or ~~below~~
Threaded ___ Welded X Surface 24
RMP ___ PVC X Weight ___ lbs./ft.
Dia. 4½ in. to 150 ft. depth Wall Thickness: inches or
Dia. ___ in. to ___ ft. depth gage No. 237

5. Type and color of material	From	To
Top soil	0	4
Brown & white sandy clay	4	42
Sand & gravel	42	55
Gray-Green clay	55	75
Sand & gravel	75	90
White clay & rock	90	108
Sand & gravel	108	120
Gray clay	120	126
Sand & gravel	126	150

(Use a second sheet if needed)

10. Screen: Manufacturer's name Peerless
Type pvc Dia.
Slot/~~gauze~~ 116 Length 20
Set between 130 ft. and 150 ft.
ft. and ft.
Gravel pack? X Size range of material ½ ⅜ ¾

11. Static water level: mo./day/yr.
35 ft. below land surface Date 6-21-77

12. Pumping level below land surfaces: NA
ft. after hrs. pumping g.p.m.
ft. after hrs. pumping g.p.m.
Estimated maximum yield g.p.m.

13. Water sample submitted: mo./day/yr.
__ Yes X No Date

14. Well head completion:
__ Pitless adapter ___ Inches above grade

15. Well grouted? X
With: X Neat cement __ Bentonite __ Concrete
Depth: From 0 ft. to 10 ft.

16. Nearest source of possible contamination:
ft. 400 Direction NW Type oil well
Well disinfected upon completion? X Yes __ No

17. Pump: X Not installed
Manufacturer's name
Model number HP Volts
Length of drop pipe ft. capacity g.p.m.
Type:
__ Submersible __ Turbine
__ Jet __ Reciprocating
__ Centrifugal __ Other

18. Elevation:
Topography:
__ Hill
__ Slope
X Upland
__ Valley

19. Remarks:

20. Water well contractor's certification:
This well was drilled under my jurisdiction and this report is true to the best of my knowledge and belief.
Rosencrantz-Bemis 134
Business name License No.
Address Great Bend, Ks. 67530
Signed Sandy Kilgore Date 7-13-77
Authorized representative

T 26 R 12 E/W Sec 11 1/4 NW 1/4 SE 1/4 NW

Forward the white, blue and pink copies to the Department of Health and Environment

Form WWC-5

MI-1023