


1 LOCATION OF WATER WELL: Fraction NE 1/4 SE 1/4 NE 1/4 Section Number 22 Township Number T 26 S Range Number R 12 W EW  
 County: Pratt

Distance and direction from nearest town or city street address of well if located within city?  
 3W 69N 330'W of Preston, Kansas

2 WATER WELL OWNER: Studer Oil Co.  
 RR#, St. Address, Box #: 113 E. 3rd street Board of Agriculture, Division of Water Resources  
 City, State, ZIP Code: Pratt, Kansas 67124 Trimpe # 2 Application Number: T85-1021

3 LOCATE WELL'S LOCATION WITH AN "X" IN SECTION BOX:

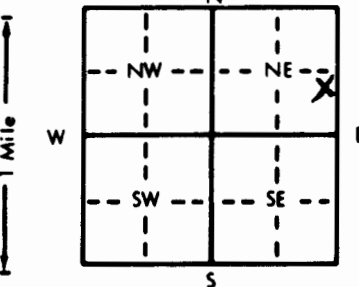

4 DEPTH OF COMPLETED WELL: 100 ft. ELEVATION:  
 Depth(s) Groundwater Encountered: 1. 37 ft. 2. ft. 3. ft.  
 WELL'S STATIC WATER LEVEL: 37 ft. below land surface measured on mo/day/yr 27 Nov 85  
 Pump test data: Well water was ft. after hours pumping gpm  
 Est. Yield: 80 gpm: Well water was ft. after hours pumping gpm  
 Bore Hole Diameter: 10 in. to 100 ft., and in. to ft.  
 WELL WATER TO BE USED AS:  
 5 Public water supply 8 Air conditioning 11 Injection well  
 1 Domestic 3 Feedlot ~~XX~~ Oil field water supply 9 Dewatering 12 Other (Specify below)  
 2 Irrigation 4 Industrial 7 Lawn and garden only 10 Observation well  
 Was a chemical/bacteriological sample submitted to Department? Yes No ~~XX~~; If yes, mo/day/yr sample was submitted  
 Water Well Disinfected? Yes ~~XX~~ No

5 TYPE OF BLANK CASING USED:  
 1 Steel 3 RMP (SR) 5 Wrought iron 8 Concrete tile CASING JOINTS: Glued ~~XX~~ Clamped  
~~XX~~ 2 PVC 4 ABS 6 Asbestos-Cement 9 Other (specify below) Welded  
 7 Fiberglass Threaded  
 Blank casing diameter: 5 in. to 80 ft., Dia. in. to ft., Dia. in. to ft.  
 Casing height above land surface: 12 in., weight: 2.34 lbs./ft. Wall thickness or gauge No. 214

TYPE OF SCREEN OR PERFORATION MATERIAL:  
 1 Steel 3 Stainless steel 5 Fiberglass 8 RMP (SR) 10 Asbestos-cement  
 2 Brass 4 Galvanized steel 6 Concrete tile 9 ABS 11 Other (specify)  
 12 None used (open hole)

SCREEN OR PERFORATION OPENINGS ARE:  
 1 Continuous slot 3 Mill slot 5 Gauzed wrapped ~~XX~~ 8 Saw cut 11 None (open hole)  
 2 Louvered shutter 4 Key punched 6 Wire wrapped 9 Drilled holes  
 7 Torch cut 10 Other (specify)

SCREEN-PERFORATED INTERVALS: From 80 ft. to 100 ft., From ft. to ft.  
 From ft. to ft., From ft. to ft.  
 GRAVEL PACK INTERVALS: From 10 ft. to 100 ft., From ft. to ft.  
 From ft. to ft., From ft. to ft.

6 GROUT MATERIAL: 1 Neat cement ~~XX~~ 2 Cement grout 3 Bentonite 4 Other  
 Grout Intervals: From 0 ft. to 10 ft., From ft. to ft., From ft. to ft.

What is the nearest source of possible contamination:  
 1 Septic tank 4 Lateral lines 7 Pit privy 10 Livestock pens 14 Abandoned water well  
 2 Sewer lines 5 Cess pool 8 Sewage lagoon 11 Fuel storage 15 Oil well/Gas well  
 3 Watertight sewer lines 6 Seepage pit 9 Feedyard 12 Fertilizer storage 16 Other (specify below)  
 13 Insecticide storage none

Direction from well? How many feet?

| FROM | TO  | LITHOLOGIC LOG                                 | FROM | TO | LITHOLOGIC LOG |
|------|-----|--|------|----|----------------|
| 0    | 2   | Soil, sandy                                    |      |    |                |
| 2    | 10  | Fine sand                                      |      |    |                |
| 10   | 33  | Clay, tan and brown                            |      |    |                |
| 33   | 51  | Sand, fine to coarse and fine gravel           |      |    |                |
| 51   | 76  | Clay, tan                                      |      |    |                |
| 76   | 100 | Sand, fine to coarse and fine to coarse gravel |      |    |                |

7 CONTRACTOR'S OR LANDOWNER'S CERTIFICATION: This water well was (1) constructed, (2) reconstructed, or (3) plugged under my jurisdiction and was completed on (mo/day/year) 27 Nov 85 and this record is true to the best of my knowledge and belief. Kansas  
 Water Well Contractor's License No. 325 This Water Well Record was completed on (mo/day/yr) 20 Dec 85  
 under the business name of Central Well and Pump by (signature) [Signature]

INSTRUCTIONS: Use typewriter or ball point pen. PLEASE PRESS FIRMLY and PRINT clearly. Please fill in blanks, underline or circle the correct answers. Send top three copies to Kansas Department of Health and Environment, Office of Oil Field and Environmental Geology, Regulation and Permitting Section, Topeka, Kansas 66620-7500, Telephone: 913-862-9360. Send one to WATER WELL OWNER and retain one for your records.

OFFICE USE ONLY  
 T  
 R  
 EW  
 SEC