

USE TYPEWRITER OR BALL
PEN. PRESS FIRMLY,
PRINT CLEARLY.


WATER WELL RECORD
KSA 82a-1201-1215

Kansas Department of Health and
Environment-Division of Environment
(Water well Contractors)
Topeka, Kansas 66620



County Pratt	Fraction 1/4 SW 1/4 SW 1/4	Section number 28	Township number T 26 S R 12	Range number EW
------------------------	--------------------------------------	-----------------------------	---------------------------------------	---------------------------

2. Distance and direction from nearest town or city: 5 1/2 miles southwest of Preston, KS Street address of well location if in city:	3. Owner of well: Merle J. Trinkle Route 1 Preston, KS 67569
---	------------------------------------------------------------------------------

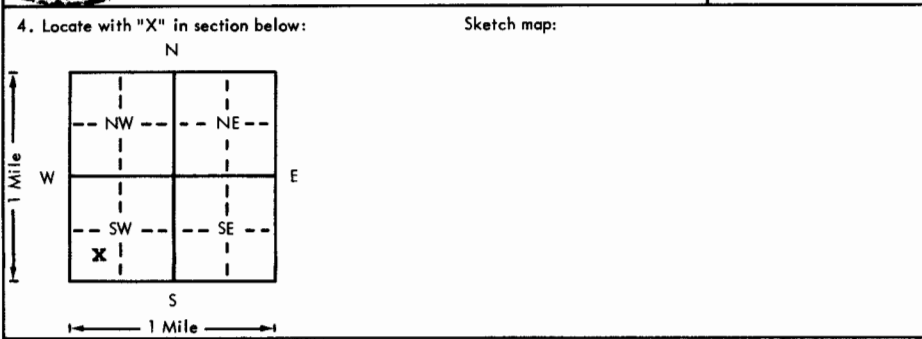

6. Bore hole dia. 9 in. Completion date 2-28-77
Well depth 81 ft.

7. Cable tool Rotary Driven Dug
 Hollow rod Jetted Bored Reverse rotary

8. Use: Domestic Public supply Industry
 Irrigation Air conditioning Stock
 Lawn Oil field water Other

9. Casing: Material Styrene Height: Above or below
Threaded Welded Surface 12 in.
RMP PVC Weight 1.5 lbs./ft.
Dia. 5 in. to 71 ft. depth; Wall Thickness: inches or
Dia. in. to ft. depth; Iga No. #200

5. Type and color of material	From	To
top soil	0	3
brown clay	3	22
sandy clay & lime streaks	22	58
sand & gravel	58	61
brown clay & limestone	61	70
sand & gravel	70	81
(Use a second sheet if needed)		

10. Screen: Manufacturer's name Jess & Lowell

Type Styrene 200 Dia. 5"
Slot gauge 1/8 Length 10'
Set between 71 ft. and 81 ft.
Gravel pack? yes Size range of material 3/8-200

11. Static water level: 53' ft. below land surface Date 2-14-77 mo./day/yr.

12. Pumping level below land surfaces: N/C
 ft. after hrs. pumping g.p.m.
 ft. after hrs. pumping g.p.m.
Estimated maximum yield g.p.m.

13. Water sample submitted: mo./day/yr.
Yes No Date

14. Well head completion:
 Pitless adapter 12 inches above grade

15. Well grouted? yes
With: Neat cement Bentonite Concrete
Depth: From 0 ft. to 10 ft.

16. Nearest source of possible contamination: FIELD
ft. Direction Type
Well disinfected upon completion? Yes No

17. Pump: Not installed
Manufacturer's name Berkeley Pump Co.
Model number 4BL-15 HP 1 Volts 230
Length of drop pipe 63 ft. capacity 15 g.p.m.
Type:
 Submersible Turbine
 Jet Reciprocating
 Centrifugal Other

18. Elevation: Topography: <input type="checkbox"/> Hill <input type="checkbox"/> Slope <input type="checkbox"/> Upland <input type="checkbox"/> Valley	19. Remarks:
---	--------------

20. Water well contractor's certification:
This well was drilled under my jurisdiction and this report is true to the best of my knowledge and belief.
Clarke Well & Eq., INC. 185
Business name License No.
Address Great Bend, KS 67530
Signed D.W. Clarke Date 3-2-77
Authorized representative

T 26 S R 12 EW
Sec 28
1/4 SW 1/4 SW 1/4