


KNOWE #13

1 LOCATION OF WATER WELL: County: <b>PRATT</b>	Fraction <b>NE 1/4 SE 1/4 NE 1/4</b>	Section Number <b>29</b>	Township Number <b>T 26 S</b>	Range Number <b>R 12 E 0</b>
---	---	-----------------------------	----------------------------------	---------------------------------

Distance and direction from nearest town or city street address of well if located within city?  
**PRESTON 4 1/2 WEST 1/4 SOUTH WESTSIDE.**

2 WATER WELL OWNER: RR#, St. Address, Box # : <b>555 N. WOODLAWN SUITE 114</b> City, State, ZIP Code : <b>WICHITA, KS 67208</b>	Board of Agriculture, Division of Water Resources Application Number: <b>T85-998</b>
---	---

3 LOCATE WELL'S LOCATION WITH AN "X" IN SECTION BOX:

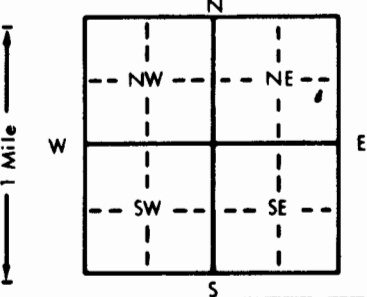

4 DEPTH OF COMPLETED WELL: <b>110</b> ft. ELEVATION:
Depth(s) Groundwater Encountered 1. <b>64</b> ft. 2. . ft. 3. . ft.
WELL'S STATIC WATER LEVEL: <b>33</b> ft. below land surface measured on mo/day/yr <b>11-15-85</b>
Pump test data: Well water was <b>7</b> ft. after . . . . . hours pumping . . . . . gpm
Est. Yield . . . . . gpm: Well water was . . . . . ft. after . . . . . hours pumping . . . . . gpm
Bore Hole Diameter: <b>7 7/8</b> in. to <b>11.0</b> . . . . . ft., and . . . . . in. to . . . . . ft.
WELL WATER TO BE USED AS:
1 Domestic 3 Feedlot 6 Oil field water supply 9 Dewatering 12 Other (Specify below)
2 Irrigation 4 Industrial 7 Lawn and garden only 10 Observation well
Was a chemical/bacteriological sample submitted to Department? Yes. . . . . No. . . . . ; If yes, mo/day/yr sample was submitted
Water Well Disinfected? Yes No

5 TYPE OF BLANK CASING USED:	5 Wrought iron	8 Concrete tile	CASING JOINTS: Glued <input checked="" type="checkbox"/> Clamped . . . . .
1 Steel 3 RMP (SR)	6 Asbestos-Cement	9 Other (specify below)	Welded . . . . .
2 PVC 4 ABS	7 Fiberglass		Threaded. . . . .
Blank casing diameter . . . <b>5</b> . . . . . in. to <b>9.0</b> . . . . . ft., Dia . . . . . in. to . . . . . ft., Dia . . . . . in. to . . . . . ft.			
Casing height above land surface . . . . . <b>1.7</b> . . . . . in., weight . . . . . <b>2.65</b> . . . . . lbs./ft. Wall thickness or gauge No. <b>214</b>			

TYPE OF SCREEN OR PERFORATION MATERIAL:	7 PVC	10 Asbestos-cement
1 Steel 3 Stainless steel 5 Fiberglass 8 RMP (SR)		11 Other (specify) . . . . .
2 Brass 4 Galvanized steel 6 Concrete tile 9 ABS		12 None used (open hole)

SCREEN OR PERFORATION OPENINGS ARE: <b>1/8</b>	5 Gauzed wrapped	8 Saw cut	11 None (open hole)
1 Continuous slot 3 Mill slot	6 Wire wrapped	9 Drilled holes	
2 Louvered shutter 4 Key punched	7 Torch cut	10 Other (specify) . . . . .	

SCREEN-PERFORATED INTERVALS: From . . . . . <b>9.0</b> . . . . . ft. to <b>11.0</b> . . . . . ft., From . . . . . ft. to . . . . . ft.
GRAVEL PACK INTERVALS: From . . . . . <b>8.0</b> . . . . . ft. to <b>11.0</b> . . . . . ft., From . . . . . ft. to . . . . . ft.

6 GROUT MATERIAL: 1 Neat cement 2 Cement grout 3 Bentonite 4 Other . . . . .
Grout Intervals: From . . . . . <b>0</b> . . . . . ft. to <b>1.0</b> . . . . . ft., From . . . . . ft. to . . . . . ft., From . . . . . ft. to . . . . . ft.
What is the nearest source of possible contamination: <b>NONE</b>
1 Septic tank 4 Lateral lines 7 Pit privy 10 Livestock pens 14 Abandoned water well
2 Sewer lines 5 Cess pool 8 Sewage lagoon 11 Fuel storage 15 Oil well/Gas well
3 Watertight sewer lines 6 Seepage pit 9 Feedyard 12 Fertilizer storage 16 Other (specify below)
13 Insecticide storage

Direction from well?			How many feet?		
FROM	TO	LITHOLOGIC LOG	FROM	TO	LITHOLOGIC LOG
0	1	TOP SOIL			
5	20	BROWN CLAY			
20	50	TAN GREY CLAY			
50	56	GRAY CLAY			
56	58	SAND & GRAVEL.			
58	63	GREY CLAY			
63	110	SAND & GRAVEL W/CLAY MIX			

7 CONTRACTOR'S OR LANDOWNER'S CERTIFICATION: This water well was (1) <u>constructed</u> , (2) reconstructed, or (3) plugged under my jurisdiction and was completed on (mo/day/year) <b>11-15-85</b> and this record is true to the best of my knowledge and belief. Kansas Water Well Contractor's License No. <b>389</b> This Water Well Record was completed on (mo/day/yr) <b>11-20-85</b> under the business name of <b>REISER WATER WELL SERV. INC.</b> by (signature) <i>Rudolph J. Reiser</i>
INSTRUCTIONS: Use typewriter or ball point pen, PLEASE PRESS FIRMLY and PRINT clearly. Please fill in blanks, underline or circle the correct answers. Send top three copies to Kansas Department of Health and Environment, Division of Environment, Environmental Geology Section, Topeka, KS 66620. Send one to WATER WELL OWNER and retain one for your records.

OFFICE USE ONLY  
T  
R  
EW  
SEC.  
1/4  
1/4  
1/4