

Petrowski #5


1 LOCATION OF WATER WELL: County: PRATT	Fraction NE 1/4 SE 1/4 NW 1/4	Section Number 30	Township Number T 26 S	Range Number R 12 EW
---	--	--------------------------	-------------------------------	-----------------------------

Distance and direction from nearest town or city street address of well if located within city?

1/4 MI 2 E 1 3/4 N EASTSIDE.

2 WATER WELL OWNER: FR#, St. Address, Box # : Box 129, 6th & Cleveland City, State, ZIP Code : Sterling, KS. 67579	Board of Agriculture, Division of Water Resources Application Number: T85-715
--	---

3 LOCATE WELL'S LOCATION WITH AN "X" IN SECTION BOX:	4 DEPTH OF COMPLETED WELL: 102 ft. ELEVATION: ---
--	---

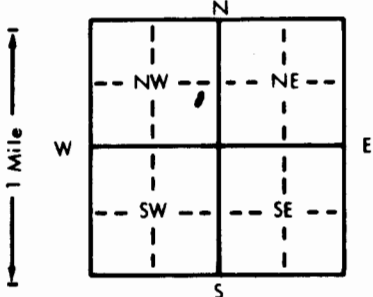

Depth(s) Groundwater Encountered 1. **75** ft. 2. **---** ft. 3. **---** ft.

WELL'S STATIC WATER LEVEL **47** ft. below land surface measured on **7-31-85** mo/day/yr

Pump test data: Well water was **---** ft. after **---** hours pumping **---** gpm

Est. Yield **---** gpm: Well water was **---** ft. after **---** hours pumping **---** gpm

Bore Hole Diameter **7 7/8** in. to **102** ft., and **---** in. to **---** ft.

WELL WATER TO BE USED AS:

5 Public water supply	8 Air conditioning	11 Injection well
1 Domestic	3 Feedlot	6 <u>Oil field water supply</u>
2 Irrigation	4 Industrial	7 Lawn and garden only
		10 Observation well

Was a chemical/bacteriological sample submitted to Department? Yes **---** No **X**; If yes, mo/day/yr sample was submitted **---**

Water Well Disinfected? Yes **---** No **X**

5 TYPE OF BLANK CASING USED:	5 Wrought iron	8 Concrete tile	CASING JOINTS: Glued X Clamped ---
1 Steel	3 RMP (SR)	6 Asbestos-Cement	9 Other (specify below)
2 <u>PVC</u>	4 ABS	7 Fiberglass	Welded ---
			Threaded ---

Blank casing diameter **5** in. to **72** ft., Dia **---** in. to **---** ft., Dia **---** in. to **---** ft.

Casing height above land surface **12** in., weight **2.65** lbs./ft. Wall thickness or gauge No. **214**

TYPE OF SCREEN OR PERFORATION MATERIAL:	7 <u>PVC</u>	10 Asbestos-cement
1 Steel	3 Stainless steel	5 Fiberglass
2 Brass	4 Galvanized steel	6 Concrete tile
		8 RMP (SR)
		9 ABS
		11 Other (specify) ---
		12 None used (open hole)

SCREEN OR PERFORATION OPENINGS ARE:	5 Gauzed wrapped	8 <u>Saw cut</u>	11 None (open hole)
1 Continuous slot	3 Mill slot	6 Wire wrapped	9 Drilled holes
2 Louvered shutter	4 Key punched	7 Torch cut	10 Other (specify) ---

SCREEN-PERFORATED INTERVALS: From **72** ft. to **102** ft., From **---** ft. to **---** ft., From **---** ft. to **---** ft.

GRAVEL PACK INTERVALS: From **62** ft. to **102** ft., From **---** ft. to **---** ft., From **---** ft. to **---** ft.

6 GROUT MATERIAL:	1 Neat cement	2 Cement grout	3 <u>Bentonite</u>	4 Other ---
-------------------	---------------	----------------	--------------------	--------------------

Grout Intervals: From **0** ft. to **10** ft., From **---** ft. to **---** ft., From **---** ft. to **---** ft.

What is the nearest source of possible contamination: **NONE**

1 Septic tank	4 Lateral lines	7 Pit privy	10 Livestock pens	14 Abandoned water well
2 Sewer lines	5 Cess pool	8 Sewage lagoon	11 Fuel storage	15 Oil well/Gas well
3 Watertight sewer lines	6 Seepage pit	9 Feedyard	12 Fertilizer storage	16 Other (specify below)
			13 Insecticide storage	

Direction from well? How many feet?

FROM	TO	LITHOLOGIC LOG	FROM	TO	LITHOLOGIC LOG
0	4	Sandy Top Soil			
4	45	CLAY			
45	70	SANDY CLAY			
70	75	FINE SAND			
75	102	GRAVEL			

7 CONTRACTOR'S OR LANDOWNER'S CERTIFICATION: This water well was (1) constructed, (2) reconstructed, or (3) plugged under my jurisdiction and was completed on (mo/day/year) **7/31/85** and this record is true to the best of my knowledge and belief. Kansas Water Well Contractor's License No. **389** This Water Well Record was completed on (mo/day/yr) **8/1/85** under the business name of Raiser Water Well Service, Inc. by (signature) Rudolph J. Raiser

INSTRUCTIONS: Use typewriter or ball point pen, PLEASE PRESS FIRMLY and PRINT clearly. Please fill in blanks, underline or circle the correct answers. Send top three copies to Kansas Department of Health and Environment, Division of Environment, Environmental Geology Section, Topeka, KS 66620. Send one to WATER WELL OWNER and retain one for your records.

OFFICE USE ONLY
T
R
EW
SEC.