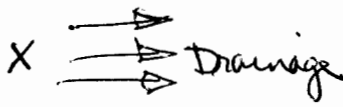


USE TYPEWRITER OR BALL POINT PEN—PRESS FIRMLY, PRINT CLEARLY.

WATER WELL RECORD  
KSA 82a-1201-1215

Kansas Department of Health and Environment—Division of Environment  
(Water well Contractors)  
Topeka, Kansas 66620

1. Location of well:		County <b>Pratt</b>	Fraction <b>SE 1/4 NW 1/4 NE 1/4</b>	Section number <b>36</b>	Township number <b>T 26S</b>	Range number <b>S R 12W 8/W</b>		
2. Distance and direction from nearest town or city: Street address of well location if in city:			3. Owner of well: <b>Gene Studer</b> R.R. or street: City, state, zip code: <b>Preston, Kansas</b>					
4. Locate with "X" in section below: N W E S 1 Mile			Sketch map: 		6. Bore hole dia. <b>30</b> in. Completion date <b>27 Aug 78</b> Well depth <b>130</b> ft.			
5. Type and color of material			From	To	7. <input type="checkbox"/> Cable tool <input type="checkbox"/> Rotary <input type="checkbox"/> Driven <input type="checkbox"/> Dug <input type="checkbox"/> Hollow rod <input type="checkbox"/> Jetted <input type="checkbox"/> Bored <input checked="" type="checkbox"/> Reverse rotary			
			<b>Soil</b>		0	2	8. Use: <input type="checkbox"/> Domestic <input type="checkbox"/> Public supply <input type="checkbox"/> Industry <input checked="" type="checkbox"/> Irrigation <input type="checkbox"/> Air conditioning <input type="checkbox"/> Stock <input type="checkbox"/> Lawn <input type="checkbox"/> Oil field water <input type="checkbox"/> Other	
			<b>Sand, fine</b>		2	7	9. Casing: Material <b>STL</b> Height <b>Above</b> or below Threaded <input type="checkbox"/> Welded <input checked="" type="checkbox"/> Surface <b>12</b> in. RMP <input type="checkbox"/> PVC <input type="checkbox"/> Weight <input type="checkbox"/> lbs./ft.	
			<b>Clay, tan</b>		7	11	Dia. <b>1 1/2</b> in. to <b>80</b> ft. depth Wall Thickness: inches or Dia. <input type="checkbox"/> in. to <input type="checkbox"/> ft. depth gage No. <b>188</b>	
			<b>Clay, white and hard</b>		11	27	10. Screen: Manufacturer's name <b>Amella &amp; Cook</b> Type <input type="checkbox"/> Dia. <b>16"</b> Slot/gauze <b>1/8" &amp; .100</b> Length <b>50'</b> Set between <b>80-90</b> ft. and <input type="checkbox"/> ft. <b>Amella 90</b> ft. and <b>130</b> ft. Gravel pack? <input checked="" type="checkbox"/> Size range of material <b>1/4" x 1/2"</b>	
			<b>Sand, fine to coarse and med. gravel, loose</b>		27	51	11. Static water level: <input type="checkbox"/> mo./day/yr. <b>37</b> ft. below land surface Date <b>27 Aug 78</b>	
			<b>Clay, white</b>		51	63	12. Pumping level below land surfaces: <b>78</b> ft. after <b>1 1/2</b> hrs. pumping <b>850</b> g.p.m. <b>81.5</b> ft. after <b>1</b> hrs. pumping <b>900</b> g.p.m. Estimated maximum yield <b>1200</b> g.p.m.	
			<b>Sand, fine to coarse</b>		63	65	13. Water sample submitted: <input type="checkbox"/> mo./day/yr. <input type="checkbox"/> Yes <input checked="" type="checkbox"/> No Date <input type="checkbox"/>	
			<b>Clay, yellow</b>		65	77	14. Well head completion: <input type="checkbox"/> Pitless adapter <b>12</b> Inches above grade	
			<b>Sand, fine to coarse with gravel streaks med. loose</b>		77	91	15. Well grouted? <input checked="" type="checkbox"/> With: <input type="checkbox"/> Neat cement <input checked="" type="checkbox"/> Bentonite <input type="checkbox"/> Concrete Depth: From <b>0</b> ft. to <b>10</b> ft.	
<b>Sand, fine to coarse med. loose</b>			91	118	16. Nearest source of possible contamination: ft. <input type="checkbox"/> Direction <input type="checkbox"/> Type <b>Abwa</b> Well disinfected upon completion? <input checked="" type="checkbox"/> Yes <input type="checkbox"/> No			
<b>Sand, fine to coarse and med. gravel, loose</b>			118	143	17. Pump: <input type="checkbox"/> Not installed Manufacturer's name <b>Floway</b> Model number <input type="checkbox"/> HP <b>75</b> Volts <b>466</b> Length of drop pipe <b>100</b> ft. capacity <b>800</b> g.p.m. Type: <input type="checkbox"/> Submersible <input checked="" type="checkbox"/> Turbine <input type="checkbox"/> Jet <input type="checkbox"/> Reciprocating <input type="checkbox"/> Centrifugal <input type="checkbox"/> Other			
<b>Clay, tan</b>			143	145	20. Water well contractor's certification: This well was drilled under my jurisdiction and this report is true to the best of my knowledge and belief. <b>Central Well &amp; Pump 325</b> Business name License No. Address <b>121 S. Taylor Pratt, Ks.</b> Signed <b>Antonovich</b> Date <b>20 July 78</b> Authorized representative			
<b>Sand, fine to coarse and fine gravel streaks med. loose</b>			145	150				
<b>Sand, fine to coarse with clay streaks</b> <small>(Use a second sheet if needed)</small>			150	155				
18. Elevation:  Topography: <input type="checkbox"/> Hill <input type="checkbox"/> Slope <input checked="" type="checkbox"/> Upland <input type="checkbox"/> Valley		19. Remarks: <b>3'x3'x8" slab at surface</b>						

Forward the white, blue and pink copies to the Department of Health and Environment

Form WWC-5