

USE TYPEWRITER OR BALL POINT PEN-PRESS FIRMLY, PRINT CLEARLY.

WATER WELL RECORD
KSA 82a-1201-1215


Kansas Department of Health and Environment-Division of Environment (Water well Contractors) Topeka, Kansas 66620

Mardis #1

1. Location of well: County Pratt Fraction SW SW NE Section number 36 Township number T 26 S Range number S 12 W E/W

2. Distance and direction from nearest town or city: 8 east
Street address of well location if in city: 1 north ~~Suba~~

3. Owner of well: D. R. Louch
R.R. or street: Wichita Kansas
City, state, zip code:

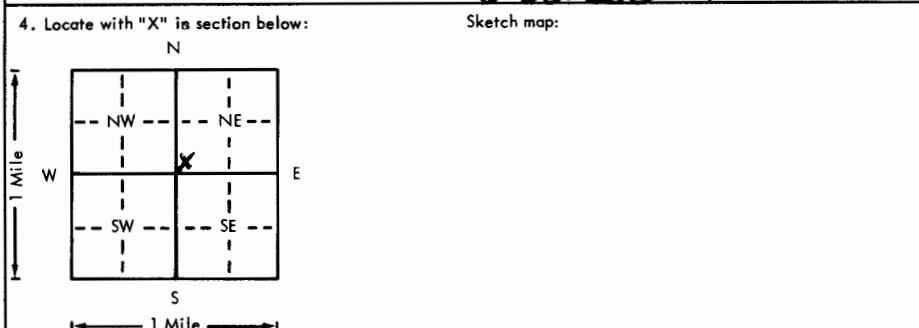

6. Bore hole dia. 5 in. Completion date 11-28-77
Well depth 105 ft.

7. Cable tool Rotary Driven Dug
 Hollow rod Jetted Bored Reverse rotary

8. Use: Domestic Public supply Industry
 Irrigation Air conditioning Stock
 Lawn Oil field water Other

9. Casing: Material Plastic Weight: Above or below
Threaded Welded Surface 12 in.
RMP PVC Weight 287.3 lbs./ft.
Dia. 5 in. to 125 ft. depth Wall Thickness: inches or
Dia. 5 in. to 125 ft. depth gage No. 202

5. Type and color of material	From	To
<u>Clay</u>	<u>0</u>	<u>15</u>
<u>Sandy Clay</u>	<u>15</u>	<u>45</u>
<u>Sand</u>	<u>45</u>	<u>85</u>
<u>Gravel</u>	<u>85</u>	<u>105</u>

10. Screen: Manufacturer's name Self made
Type PVC Dia. 5
Gauge 3 Length 20
Set between 85 ft. and 105 ft.
Gravel pack? yes Size range of material 3/4

11. Static water level: 54 ft. below land surface Date 11-28-77 mo./day/yr.

12. Pumping level below land surfaces:
____ ft. after ____ hrs. pumping ____ g.p.m.
____ ft. after ____ hrs. pumping ____ g.p.m.
Estimated maximum yield ____ g.p.m.

13. Water sample submitted: ____ mo./day/yr.
Yes No Date ____

14. Well head completion:
 Pitless adapter ____ inches above grade

15. Well grouted? yes
With: Neat cement Bentonite Concrete
Depth: From 0 ft. to 10 ft.

16. Nearest source of possible contamination:
ft. ____ Direction ____ Type ____
Well disinfected upon completion? Yes No

17. Pump: Not installed
Manufacturer's name ____
Model number ____ HP ____ Volts ____
Length of drop pipe ____ ft. capacity ____ g.p.m.
Type:
 Submersible Turbine
 Jet Reciprocating
 Centrifugal Other

18. Elevation: Topography: Hill Slope Upland Valley

19. Remarks:

20. Water well contractor's certification:
This well was drilled under my jurisdiction and this report is true to the best of my knowledge and belief.
Business name Murray Water Well License No. 143
Address 143 Bend Ks
Signed C. Murray Date 11-28-77
Authorized representative

T 26 S 12 W 36 Sec 36 S 12 W NE

Forward the white, blue and pink copies to the Department of Health and Environment

Form WWC-5