

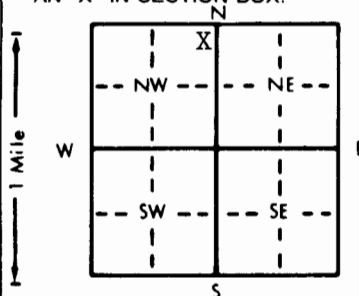
WATER WELL RECORD Form WWC-5 KSA 82a-1212

1 LOCATION OF WATER WELL:	Fraction	Section Number	Township Number	Range Number
County: <u>Pratt</u>	<u>NE 1/4 NE 1/4 NW 1/4</u>	<u>3</u>	<u>T 26 S</u>	<u>R 13w EW</u>

Distance and direction from nearest town or city street address of well if located within city?

5N of Iuka, Ks.

2 WATER WELL OWNER: <u>Reginald Wade Harrison</u>	Board of Agriculture, Division of Water Resources
RR#, St. Address, Box #: <u>RR 2, Box 151</u>	Application Number:
City, State, ZIP Code: <u>St. John, Ks. 67536</u>	

3 LOCATE WELL'S LOCATION WITH AN "X" IN SECTION BOX:	4 DEPTH OF COMPLETED WELL: <u>75</u> ft. ELEVATION: <u>unknown</u>
	Depth(s) Groundwater Encountered 1. <u>15</u> ft. 2. ft. 3. ft.
	WELL'S STATIC WATER LEVEL <u>15</u> ft. below land surface measured on mo/day/yr <u>9-13-97</u>
	Pump test data: Well water was ft. after hours pumping gpm
	Est. Yield <u>30</u> gpm: Well water was ft. after hours pumping gpm
	Bore Hole Diameter: <u>8</u> in. to <u>7.5</u> ft., and in. to ft.
	WELL WATER TO BE USED AS: 5 Public water supply 8 Air conditioning 11 Injection well
	1 Domestic 3 Feedlot 6 Oil field water supply 9 Dewatering 12 Other (Specify below)
	2 Irrigation 4 Industrial 7 Lawn and garden only 10 Monitoring well
	Was a chemical/bacteriological sample submitted to Department? Yes No If yes, mo/day/yr sample was sub- mitted
	Water Well Disinfected? Yes No

5 TYPE OF BLANK CASING USED:	5 Wrought iron	8 Concrete tile	CASING JOINTS: <u>Glued</u> Clamped
1 Steel	3 RMP (SR)	6 Asbestos-Cement	9 Other (specify below)
2 PVC	4 ABS	7 Fiberglass	10 Asbestos-cement
Blank casing diameter <u>5</u> in. to <u>5.5</u> ft., Dia in. to ft., Dia in. to ft.			11 Other (specify)
Casing height above land surface <u>12</u> in., weight <u>2.8</u> lbs./ft. Wall thickness or gauge No. <u>Sch. 40</u>			12 None used (open hole)
TYPE OF SCREEN OR PERFORATION MATERIAL:	7 PVC		
1 Steel	3 Stainless steel	5 Fiberglass	8 RMP (SR)
2 Brass	4 Galvanized steel	6 Concrete tile	9 ABS
SCREEN OR PERFORATION OPENINGS ARE:	5 Gauzed wrapped	8 Saw cut	11 None (open hole)
1 Continuous slot	3 Mill slot	6 Wire wrapped	9 Drilled holes
2 Louvered shutter	4 Key punched	7 Torch cut	10 Other (specify)
SCREEN-PERFORATED INTERVALS: From <u>55</u> ft. to <u>75</u> ft., From ft. to ft.			
GRAVEL PACK INTERVALS: From <u>20</u> ft. to <u>75</u> ft., From ft. to ft.			

6 GROUT MATERIAL:	1 Neat cement	2 Cement grout	3 Bentonite	4 Other
Grout Intervals: From <u>0</u> ft. to <u>20</u> ft., From ft. to ft., From ft. to ft.				
What is the nearest source of possible contamination:	10 Livestock pens	14 Abandoned water well		
1 Septic tank	4 Lateral lines	7 Pit privy	11 Fuel storage	15 Oil well/Gas well
2 Sewer lines	5 Cess pool	8 Sewage lagoon	12 Fertilizer storage	16 Other (specify below)
3 Watertight sewer lines	6 Seepage pit	9 Feedyard	13 Insecticide storage	<u>no source - in field</u>
Direction from well?	How many feet?			

FROM	TO	LITHOLOGIC LOG	FROM	TO	PLUGGING INTERVALS
0	3	top soil			
3	40	clay			
40	75	sand and gravel			

7 CONTRACTOR'S OR LANDOWNER'S CERTIFICATION: This water well was (1) <u>constructed</u> , (2) reconstructed, or (3) plugged under my jurisdiction and was completed on (mo/day/year) <u>9-13-97</u> and this record is true to the best of my knowledge and belief. Kansas Water Well Contractor's License No. <u>186</u> This Water Well Record was completed on (mo/day/yr) <u>9-14-97</u> under the business name of <u>Kelly's Water Well Service, Inc.</u> by (signature) <i>Kathryn A Good</i>
--