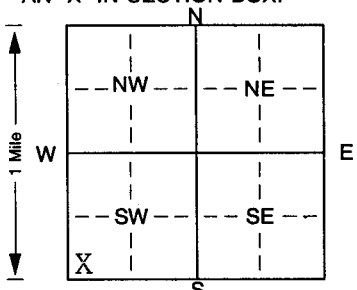


1] LOCATION OF WATER WELL: Fraction Section Number Township Number Range Number
 County: Pratt SW 1/4 SW 1/4 SW 1/4 11 T 26 S R 13 ~~W~~

Distance and direction from nearest town or city street address of well if located within city?
 1 1/2 east, 1 north of Strickler, KS

2] WATER WELL OWNER: Faye Keller
 RR#, St. Address, Box # : 10268 NE 90th Rd Board of Agriculture, Division of Water Resources
 City, State, ZIP Code : Iuka, KS 67066 Application Number:

3] LOCATE WELL'S LOCATION WITH AN "X" IN SECTION BOX:

 4] DEPTH OF COMPLETED WELL: 47 ft. ELEVATION:
 Depth(s) Groundwater Encountered 1. ft. 2. ft. 3. ft.
 WELL'S STATIC WATER LEVEL: 21 ft. below land surface measured on mo/day/yr 12-14-01
 Pump test data: Well water was ft. after hours pumping gpm
 Est. Yield: NA gpm; Well water was ft. after hours pumping gpm
 Bore Hole Diameter: 9 7/8 in. to 47 ft., and in. to ft.
 WELL WATER TO BE USED AS:
 5 Public water supply 8 Air conditioning 11 Injection well
 1 Domestic 3 Feedlot 6 Oil field water supply 9 Dewatering 12 Other (Specify below)
 2 Irrigation 4 Industrial 7 Domestic (lawn & garden) 10 Monitoring well Stock Well
 Was a chemical/bacteriological sample submitted to Department? Yes. No. ; If yes, mo/day/yr sample was submitted
 Water Well Disinfected? Yes No

5] TYPE OF BLANK CASING USED:
 1 Steel 3 RMP (SR) 5 Wrought iron 8 Concrete tile CASING JOINTS: Glued. Clamped.
 2 PVC 4 ABS 6 Asbestos-Cement 9 Other (specify below) Welded
 7 Fiberglass Threaded.
 Blank casing diameter: 5 in. to 27 ft., Dia. in. to ft., Dia. in. to ft.
 Casing height above land surface: 24 in., weight SDR-26 lbs./ft. Wall thickness or gauge No.
 TYPE OF SCREEN OR PERFORATION MATERIAL:
 1 Steel 3 Stainless steel 5 Fiberglass 7 PVC 10 Asbestos-cement
 2 Brass 4 Galvanized steel 6 Concrete tile 8 RMP (SR) 11 Other (specify)
 9 ABS 12 None used (open hole)
 SCREEN OR PERFORATION OPENINGS ARE:
 1 Continuous slot 3 Mill slot 5 Gauzed wrapped 8 Saw cut 11 None (open hole)
 2 Louvered shutter 4 Key punched 6 Wire wrapped 9 Drilled holes
 7 Torch cut 10 Other (specify) ft.
 SCREEN-PERFORATED INTERVALS: From: 47 ft. to 27 ft., From ft. to ft.
 From: ft. to ft., From ft. to ft.
 GRAVEL PACK INTERVALS: From: 47 ft. to 20 ft., From ft. to ft.
 From: ft. to ft., From ft. to ft.

6] GROUT MATERIAL: 1 Neat cement 2 Cement grout 3 Bentonite 4 Other: hole plug
 Grout Intervals: From: 20 ft. to 0 ft., From ft. to ft., From ft. to ft.
 What is the nearest source of possible contamination:
 1 Septic tank 4 Lateral lines 7 Pit privy 10 Livestock pens 14 Abandoned water well
 2 Sewer lines 5 Cess pool 8 Sewage lagoon 11 Fuel storage 15 Oil well/Gas well
 3 Watertight sewer lines 6 Seepage pit 9 Feedyard 12 Fertilizer storage 16 Other (specify below)
 13 Insecticide storage None
 Direction from well? How many feet?

FROM	TO	LITHOLOGIC LOG	FROM	TO	PLUGGING INTERVALS
0	2	top soil			
2	16	reddish brown clay			
16	26	sand and gravel clean, medium, loose			
26	30	sandy tan clay			
30	47	sand and gravel clean, small, tight			

7] CONTRACTOR'S OR LANDOWNER'S CERTIFICATION: This water well was (1) constructed, (2) reconstructed, or (3) plugged under my jurisdiction and was completed on (mo/day/year) 12-14-01 and this record is true to the best of my knowledge and belief. Kansas Water Well Contractor's Licence No. 134 This Water Well Record was completed on (mo/day/yr) 12-27-01 under the business name of Rosencrantz-Bemis by (signature) Fredia Hedson