


1	LOCATION OF WATER WELL:	Fraction	Section Number	Township Number	Range Number
County:	Pratt	NW 1/4 SE 1/4 SW 1/4	29	T 26 S	R 13 E (W)

Distance and direction from nearest town or city street address of well if located within city?

Approximately 1 1/4 miles north and 2 miles west of luka.

2 WATER WELL OWNER: **Pratt Feeders, Inc.**
 RR#, St. Address, Box # **P.O. Box 945**
 City, State, ZIP Code **Pratt, KS 67124**
 Board of Agriculture, Division of Water Resources
 Application Number: _____

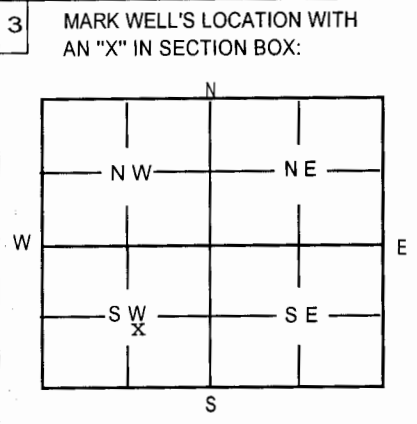

4 DEPTH OF WELL 126 ft
 WELL'S STATIC WATER LEVEL 32 ft.
 WELL WAS USED AS:
 1 Domestic 5 Public Water Supply 9 Dewatering
2 Irrigation 6 Oil Field Water Supply 10 Monitoring Well
 3 Feedlot 7 Domestic (Lawn & Garden) 11 Injection Well
 4 Industrial 8 Air Conditioning 12 Other _____

Was a chemical / bacteriological sample submitted to Department? Yes _____ No
 If yes, mo/day/yr sample was submitted _____
 Water Well Disinfected: Yes No _____

5 TYPE OF BLANK CASING USED:
 1 **Steel** 3 RMP (SR) 5 Wrought 7 Fiberglass 9 Other (Specify below)
 2 PVC 4 ABS 6 Asbestos-Cement 8 Concrete Tile

Blank casing diameter 16 in. Was casing pulled? Yes _____ No If yes, how much _____
 Casing height above or **below** land surface 48 in.

6 GROUT PLUG MATERIAL: 1 Neat Cement 2 Cement grout 3 Bentonite **4 Other Concrete Grout**

Grout Plug Intervals: From _____ ft. to _____ ft., From _____ ft. to _____ ft. From 40 ft. to 4 ft.

What is the nearest source of possible contamination:
 1 Septic tank 6 Seepage pit 11 Fuel storage **16 Other (specify below)**
 2 Sewer lines 7 Pit privy 12 Fertilizer storage
 3 Watertight sewer lines 8 Sewage lagoon 13 Insecticide storage None known
 4 Lateral lines 9 Feedyard 14 Abandoned water well
 5 Cess Pool 10 Livestock pens 15 Oil well/Gas well

Direction from well? _____ How many feet? _____

FROM	TO	PLUGGING MATERIALS
126	40	Chlorinated Sand
40	4	Concrete Grout
4	0	Compacted Soil

7 CONTRACTOR'S OR LANDOWNER'S CERTIFICATION: This water well was plugged under my jurisdiction and was completed on (mo/day/year) 05-20-08 and this record is true to the best of my knowledge and belief. Kansas Water Well Contractor's License No. 771 This Water Well Record was completed on (mo/day/year) 05-22-08 under the business name of Clarke Well & Equipment, Inc.
 by (signature) *[Signature]*

INSTRUCTIONS: Use typewriter or ball point pen. Please press firmly and print clearly. Please fill in blanks, underline or circle the correct answers. Send top three copies to Kansas Department of Health & Environment, Bureau of Water, Topeka, Kansas 66620-0001. Telephone: 785/296-3565. Send one to Water Well Owner and retain one for your records.