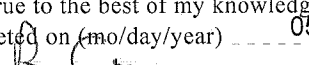


<b>1 LOCATION OF WATER WELL:</b> County: Pratt		Fraction 1/4 SE 1/4 SE 1/4 SW 1/4	Section Number 16	Township No. T 26 S	Range Number R 13 <input type="checkbox"/> E <input checked="" type="checkbox"/> W	
Street/Rural Address of Well Location; if unknown, distance & direction from nearest town or intersection: If at owner's address, check here <input type="checkbox"/> Approximately 3.5 miles north and 1 mile west of Iuka.			<b>Global Positioning System (GPS) information:</b> Latitude: 37.778363 (in decimal degrees) Longitude: -98.749606 (in decimal degrees) Elevation: Unknown Datum: <input type="checkbox"/> WGS 84, <input checked="" type="checkbox"/> NAD 83, <input type="checkbox"/> NAD 27 Collection Method: <input checked="" type="checkbox"/> GPS unit (Make/Model: WAAS) <input type="checkbox"/> Digital Map/Photo, <input type="checkbox"/> Topographic Map, <input type="checkbox"/> Land Survey Est. Accuracy: <input type="checkbox"/> <3 m, <input checked="" type="checkbox"/> 3-5 m, <input type="checkbox"/> 5-15 m, <input type="checkbox"/> >15 m	
<b>2 WATER WELL OWNER:</b> CDM Smith RR#, Street Address, Box #: 345 Riverview - Suite 520 City, State, ZIP Code : Wichita, KS 67203	
<b>3 LOCATE WELL WITH AN "X" IN SECTION BOX:</b> N W <table border="1" style="display: inline-table; text-align: center; width: 100px; height: 100px;"><tr><td>--NW--</td><td>--NE--</td></tr><tr><td>--SW--</td><td>--SE--</td></tr><tr><td colspan="2" style="text-align: center;">x</td></tr></table> E S [----- 1 mile -----]		--NW--	--NE--	--SW--	--SE--	x		<b>4 DEPTH OF COMPLETED WELL</b> 75 ft. Depth(s) Groundwater Encountered (1) _____ ft. (2) _____ ft. (3) _____ ft. WELL'S STATIC WATER LEVEL 32 ft. below land surface measured on mo/day/yr 05/23/13 Pump test data: Well water was not checked ft. after _____ hours pumping _____ gpm EST. YIELD _____ gpm. Well water was _____ ft. after _____ hours pumping _____ gpm Bore Hole Diameter 18 in. to 78 ft., and _____ in. to _____ ft. WELL WATER TO BE USED AS: <input type="checkbox"/> Public water supply <input type="checkbox"/> Geothermal <input type="checkbox"/> Injection well <input type="checkbox"/> Domestic <input type="checkbox"/> Feedlot <input checked="" type="checkbox"/> Oil field water supply <input type="checkbox"/> Dewatering <input type="checkbox"/> Other (Specify below) <input type="checkbox"/> Irrigation <input type="checkbox"/> Industrial <input type="checkbox"/> Domestic-lawn & garden <input type="checkbox"/> Monitoring well Was a chemical/bacteriological sample submitted to Department? <input type="checkbox"/> Yes <input checked="" type="checkbox"/> No If yes, mo/day/yr sample was submitted _____ Water well disinfected? <input checked="" type="checkbox"/> Yes <input type="checkbox"/> No	
--NW--	--NE--	
--SW--	--SE--	
x	
<b>5 TYPE OF CASING USED:</b> <input type="checkbox"/> Steel <input checked="" type="checkbox"/> PVC <input type="checkbox"/> Other _____ <b>CASING JOINTS:</b> <input checked="" type="checkbox"/> Glued <input type="checkbox"/> Clamped <input type="checkbox"/> Welded <input type="checkbox"/> Threaded Casing diameter 10 in. to 55 ft., Diameter _____ in. to _____ ft., Diameter _____ in. to _____ ft. Casing height above land surface 0 in., Weight 9.03 lbs./ft., Wall thickness or gauge No. 413 <b>TYPE OF SCREEN OR PERFORATION MATERIAL:</b> <input type="checkbox"/> Steel <input type="checkbox"/> Stainless Steel <input checked="" type="checkbox"/> PVC <input type="checkbox"/> Other (Specify) _____ <input type="checkbox"/> Brass <input type="checkbox"/> Galvanized Steel <input type="checkbox"/> None used (open hole) <b>SCREEN OR PERFORATION OPENINGS ARE:</b> <input type="checkbox"/> Continuous slot <input checked="" type="checkbox"/> Mill slot <input type="checkbox"/> Gauze wrapped <input type="checkbox"/> Torch cut <input type="checkbox"/> Drilled holes <input type="checkbox"/> None (open hole) <input type="checkbox"/> Louvered shutter <input type="checkbox"/> Key punched <input type="checkbox"/> Wire wrapped <input type="checkbox"/> Saw cut <input type="checkbox"/> Other (specify) _____ <b>SCREEN-PERFORATED INTERVALS:</b> From 55 ft. to 75 ft., From _____ ft. to _____ ft. From _____ ft. to _____ ft., From _____ ft. to _____ ft. <b>GRAVEL PACK INTERVALS:</b> From 20 ft. to 78 ft., From _____ ft. to _____ ft. From _____ ft. to _____ ft., From _____ ft. to _____ ft.	
<b>6 GROUT MATERIAL:</b> <input type="checkbox"/> Neat cement <input type="checkbox"/> Cement grout <input checked="" type="checkbox"/> Bentonite <input type="checkbox"/> Other _____ Grout Intervals: From 0 ft. to 20 ft., From _____ ft. to _____ ft., From _____ ft. to _____ ft. What is the nearest source of possible contamination: <input type="checkbox"/> Septic tank <input type="checkbox"/> Lateral lines <input type="checkbox"/> Pit privy <input type="checkbox"/> Livestock pens <input type="checkbox"/> Insecticide storage <input checked="" type="checkbox"/> Other (specify below) <input type="checkbox"/> Sewer lines <input type="checkbox"/> Cesspool <input type="checkbox"/> Sewage lagoon <input type="checkbox"/> Fuel storage <input type="checkbox"/> Abandoned water well <input type="checkbox"/> Watertight sewer lines <input type="checkbox"/> Seepage pit <input type="checkbox"/> Feedyard <input type="checkbox"/> Fertilizer storage <input type="checkbox"/> Oil well/gas well Direction from well _____ Distance from well _____ None Known	
<table border="1" style="width:100%; border-collapse: collapse;"><thead><tr><th>FROM</th><th>TO</th><th>LITHOLOGIC LOG</th><th>FROM</th><th>TO</th><th>LITHO. LOG (cont.) or PLUGGING INTERVALS</th></tr></thead><tbody><tr><td>0</td><td>6</td><td>Sandy, clay</td><td></td><td></td><td></td></tr><tr><td>6</td><td>20</td><td>Clay, silty</td><td></td><td></td><td></td></tr><tr><td>20</td><td>30</td><td>Sand &amp; gravel, clay streaks</td><td></td><td></td><td></td></tr><tr><td>30</td><td>45</td><td>Fine sand &amp; fine gravel</td><td></td><td></td><td></td></tr><tr><td>45</td><td>75</td><td>Sand &amp; gravel, fine to medium</td><td></td><td></td><td></td></tr><tr><td>75</td><td>78</td><td>Clay, yellow &amp; gray</td><td></td><td></td><td></td></tr><tr><td> </td><td> </td><td> </td><td> </td><td> </td><td> </td></tr><tr><td> </td><td> </td><td> </td><td> </td><td> </td><td> </td></tr><tr><td> </td><td> </td><td> </td><td> </td><td> </td><td> </td></tr><tr><td> </td><td> </td><td> </td><td> </td><td> </td><td> </td></tr></tbody></table>						FROM	TO	LITHOLOGIC LOG	FROM	TO	LITHO. LOG (cont.) or PLUGGING INTERVALS	0	6	Sandy, clay				6	20	Clay, silty				20	30	Sand & gravel, clay streaks				30	45	Fine sand & fine gravel				45	75	Sand & gravel, fine to medium				75	78	Clay, yellow & gray																											
FROM	TO	LITHOLOGIC LOG	FROM	TO	LITHO. LOG (cont.) or PLUGGING INTERVALS	
0	6	Sandy, clay	
6	20	Clay, silty	
20	30	Sand & gravel, clay streaks	
30	45	Fine sand & fine gravel	
45	75	Sand & gravel, fine to medium	
75	78	Clay, yellow & gray	
<b>7 CONTRACTOR'S OR LANDOWNER'S CERTIFICATION:</b> This water well was <input checked="" type="checkbox"/> constructed, <input type="checkbox"/> reconstructed, or <input type="checkbox"/> plugged under my jurisdiction and was completed on (mo/day/year) 05/23/13 and this record is true to the best of my knowledge and belief. Kansas Water Well Contractor's License No. 185 This Water Well Record was completed on (mo/day/year) 05/28/13 under the business name of Clarke Well & Equipment, Inc. by (signature) 	
INSTRUCTIONS: Use typewriter or ball point pen. PLEASE PRESS FIRMLY and PRINT clearly. Please fill in blanks and check the correct answers. Send three copies (white, blue, pink) to Kansas Department of Health and Environment, Bureau of Water, Geology Section, 1000 SW Jackson St., Suite 420, Topeka, Kansas 66612-1367. Telephone 785-296-5522. Send one copy to WATER WELL OWNER and retain one for your records. Include fee of \$5.00 for each constructed well. Visit us at <a href="http://www.kdheks.gov/waterwell/index.html">http://www.kdheks.gov/waterwell/index.html</a> .	