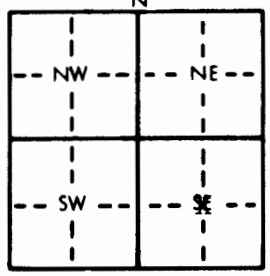


1 LOCATION OF WATER WELL: Fraction 1/4 1/4 SE 1/4 Section Number 1 Township Number T 26 S Range Number R 13 E/W
 County: Pratt

Distance and direction from nearest town or city street address of well if located within city?
Approx. 5 1/4 miles North and 2 3/4 miles east of Iuka, KS


2 WATER WELL OWNER: Andrew Griffith
 RR#, St. Address, Box # :
 City, State, ZIP Code : Iuka, KS 67066
 Board of Agriculture, Division of Water Resources
 Application Number: 35534

3 LOCATE WELL'S LOCATION WITH AN "X" IN SECTION BOX:

 4 DEPTH OF COMPLETED WELL: 160 ft. ELEVATION: Unknown
 Depth(s) Groundwater Encountered 1. 29' ft. 2. _____ ft. 3. _____ ft.
 WELL'S STATIC WATER LEVEL 29 ft. below land surface measured on mo/day/yr 6-15-82
 Pump test data: Well water was not ck'd ft. after _____ hours pumping _____ gpm
 Est. Yield unknown gpm: Well water was _____ ft. after _____ hours pumping _____ gpm
 Bore Hole Diameter 24 in. to 160 ft., and _____ in. to _____ ft.
 WELL WATER TO BE USED AS: 5 Public water supply 8 Air conditioning 11 Injection well
 1 Domestic 3 Feedlot 6 Oil field water supply 9 Dewatering 12 Other (Specify below)
2 Irrigation 4 Industrial 7 Lawn and garden only 10 Observation well
 Was a chemical/bacteriological sample submitted to Department? Yes _____ No X _____; If yes, mo/day/yr sample was submitted
 Water Well Disinfected? Yes _____ No X _____

5 TYPE OF BLANK CASING USED:
 1 Steel 3 RMP (SR) 5 Wrought iron 8 Concrete tile CASING JOINTS: Glued _____ Clamped _____
 2 PVC 4 ABS 6 Asbestos-Cement 9 Other (specify below) Welded XX
 7 Fiberglass _____ Threaded _____
 Blank casing diameter 16 in. to 60 ft., Dia _____ in. to _____ ft., Dia _____ in. to _____ ft.
 Casing height above land surface 12 in., weight 42,05 lbs./ft. Wall thickness or gauge No. 250
 TYPE OF SCREEN OR PERFORATION MATERIAL:
 1 Steel 3 Stainless steel 5 Fiberglass 7 PVC 10 Asbestos-cement
 2 Brass 4 Galvanized steel 6 Concrete tile 9 ABS 11 Other (specify) _____
 12 None used (open hole)
 SCREEN OR PERFORATION OPENINGS ARE:
 1 Continuous slot 3 Mill slot 5 Gauzed wrapped 8 Saw cut 11 None (open hole)
 2 Louvered shutter 4 Key punched 6 Wire wrapped 9 Drilled holes
 7 Torch cut 10 Other (specify) Doerr Bridge Slot
 SCREEN-PERFORATED INTERVALS: From 60 ft. to 160 ft., From _____ ft. to _____ ft.
 From _____ ft. to _____ ft., From _____ ft. to _____ ft.
 GRAVEL PACK INTERVALS: From 10 ft. to 160 ft., From _____ ft. to _____ ft.
 From _____ ft. to _____ ft., From _____ ft. to _____ ft.

6 GROUT MATERIAL: 1 Neat cement 2 Cement grout 3 Bentonite 4 Other _____
 Grout Intervals: From 0 ft. to 10 ft., From _____ ft. to _____ ft., From _____ ft. to _____ ft.
 What is the nearest source of possible contamination:
 1 Septic tank 4 Lateral lines 7 Pit privy 10 Livestock pens 14 Abandoned water well
 2 Sewer lines 5 Cess pool 8 Sewage lagoon 11 Fuel storage 15 Oil well/Gas well
 3 Watertight sewer lines 6 Seepage pit 9 Feedyard 12 Fertilizer storage 16 Other (specify below)
FIELD
 13 Insecticide storage
 Direction from well? all How many feet?

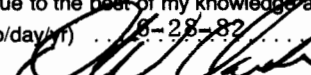FROM	TO	LITHOLOGIC LOG	FROM	TO	LITHOLOGIC LOG
0	28	Topsoil & sandy brown clay	108	117	Tan clay w/caliche
28	53	Sand & gravel, med. to coarse, clean w/a few thin clay streaks	117	125	Sand & gravel, med. to fine, clean
			125	140	Tan clay w/hard streaks of cemented sand @ 137' - 138'
53	55	Sand & sandy clay			
55	60	Sand & gravel, fine w/a lot of clay streaks	140	154	Sand & gravel, fine to very fine, clean
60	67	Sand & gravel, fine, clean	154	160	Sand & gravel, med. to fine, clean
67	74	Sandy tan clay			
74	83	Sand & gravel, fine, clean w/a couple thin clay streaks			
83	85	Very sandy tan clay			
85	92	Sand & gravel, med. - fine, clean w/streaks of clay @ 89' & 90'			
92	101	Sandy tan clay			
101	108	Sand & gravel, fine, some med.			

7 CONTRACTOR'S OR LANDOWNER'S CERTIFICATION: This water well was (1) constructed, (2) reconstructed, or (3) plugged under my jurisdiction and was completed on (mo/day/year) 6-15-82 and this record is true to the best of my knowledge and belief. Kansas Water Well Contractor's License No. 185. This Water Well Record was completed on (mo/day/yr) 6-28-82 under the business name of CLARKE WELL & EQ., INC. by (signature) 

INSTRUCTIONS: Use typewriter or ball point pen, PLEASE PRESS FIRMLY and PRINT clearly. Please fill in blanks, underline or circle the correct answers. Send top three copies to Kansas Department of Health and Environment, Division of Environment, Environmental Geology Section, Topeka, KS 66620. Send one to WATER WELL OWNER and retain one for your records.

OFFICE USE ONLY

T

26

R

13

EW

SEC

1/4

SE 1/4

1/4