USE TYPEWRITER OR BALL POINT PEN-PRESS FIRMLY, PRINT CLEARLY.

WATER WELL RECORD
KSA 82a-1201-1215

Kansas Department of Health and Environment-Division of Environment
(Water well Contractors)
Topeka, Kansas 66620

1. Location of well:	County	Fraction	Section number	Township number	Range number
	Pratt	Center of 1/4 SE 1/4 NE 1/4	9	T 26 S	R 13 E/W

2. Distance and direction from nearest town or city:
4½ miles North of Iuka, KS
Street address of well location if in city:

3. Owner of well: Andrew Griffith
R.R. or street: (?)
City, state, zip code: Iuka, KS 67066

4. Locate with "X" in section below:

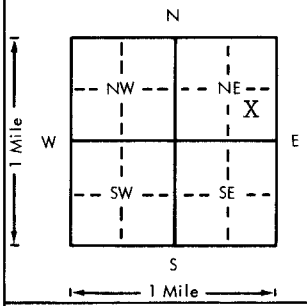

Sketch map:

6. Bore hole dia. 24 in. Completion date 10-5-78
Well depth 92 ft. Pump Set 12-5-78

7. __ Cable tool __ Rotary __ Driven __ Dug
__ Hollow rod __ Jetted __ Bored X Reverse rotary

8. Use: __ Domestic __ Public supply __ Industry
X Irrigation __ Air conditioning __ Stock
__ Lawn __ Oil field water __ Other

9. Casing: Material Steel Height: Above or below
Threaded ___ Welded X Surface 12 in.
RMP ___ PVC ___ Weight 30.3 lbs./ft.
Dia. 16 in. to 49 ft. depth Wall Thickness: inches or
Dia. 16 in. to 92 ft. depth gage No. .7 ga.

5. Type and color of material	From	To
Top soil & sand	0	12
Sandy clay & sand ~~xxxxx~~ streaks	12	45
Sand, gravel & clay streaks	45	52
Sand & gravel	52	66
Brown clay & gravel	66	70
Sand & gravel	70	82
Sand & gravel & hard cemented streaks	82	86
Brown clay & limestone	86	92
(Use a second sheet if needed)		

10. Screen: Manufacturer's name Cook
Type Cook-V-Wire Dia. 16"
Slot gauze 1/8" Length 40'
Set between 48 ft. and 89 ft.
___ ft. and ___ ft.
Gravel pack? Yes Size range of material 3/8-200

11. Static water level: mo./day/yr.
32'6" ft. below land surface Date 10-5-78

12. Pumping level below land surfaces: Not Checked
___ ft. after ___ hrs. pumping ___ g.p.m.
___ ft. after ___ hrs. pumping ___ g.p.m.
Estimated maximum yield ___ g.p.m.

13. Water sample submitted: mo./day/yr.
___ Yes X No Date ___

14. Well head completion:
___ Pitless adapter 12 Inches above grade

15. Well grouted? Yes
With: X Neat cement ___ Bentonite ___ Concrete
Depth: From 0 ft. to 10 ft.

16. Nearest source of possible contamination: FIELD
ft. ___ Direction ___ Type ___
Well disinfected upon completion? ___ Yes XXX No

17. Pump: ___ Not installed
Manufacturer's name Peerless Pump Co.
Model number 12LB-4 HP 80 Volts ---
Length of drop pipe 80 ft. capacity 900 g.p.m.
Type:
___ Submersible X Turbine
___ Jet ___ Reciprocating
___ Centrifugal ___ Other

18. Elevation:

Topography:
___ Hill
___ Slope
___ Upland
___ Valley

19. Remarks: 10393? (AOD)

20. Water well contractor's certification:
This well was drilled under my jurisdiction and this report is true to the best of my knowledge and belief.
Clarke Well & Eq., Inc. 185
Business name License No.
Address Great Bend KS 67530
Signed [signature] Date 12-6-78
Authorized representative

T 26 R 13 E/W Sec 9 1/4 SE 1/4 1/4 NE

Forward the white, blue and pink copies to the Department of Health and Environment

Form WWC-5

M1-1023