


1 LOCATION OF WATER WELL: Fraction Section Number Township Number Range Number
 County: Pratt SE 1/4 NW 1/4 SW 1/4 9 T 26 S R 13 E/W

Distance and direction from nearest town or city street address of well if located within city?
 Approximately 4 1/4 Miles North and 1 Mile West of Iuka

2 WATER WELL OWNER: Phil Shrack
 RR#, St. Address, Box # : Board of Agriculture, Division of Water Resources
 City, State, ZIP Code : Iuka, KS 67066 Application Number: 38508

3 LOCATE WELL'S LOCATION WITH AN "X" IN SECTION BOX:

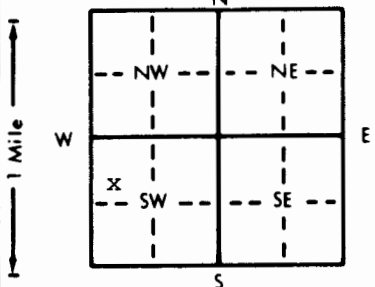

4 DEPTH OF COMPLETED WELL .75 ft. ELEVATION:
 Depth(s) Groundwater Encountered 1. ft. 2. ft. 3. ft.
 WELL'S STATIC WATER LEVEL 22 ft. below land surface measured on mo/day/yr
 Pump test data: Well water was Not Ch'd ft. after hours pumping gpm
 Est. Yield unknown gpm: Well water was ft. after hours pumping gpm
 Bore Hole Diameter .26 in. to .74 ft. and in. to ft.
 WELL WATER TO BE USED AS: 5 Public water supply 8 Air conditioning 11 Injection well
 1 Domestic 3 Feedlot 6 Oil field water supply 9 Dewatering 12 Other (Specify below)
 2 Irrigation 4 Industrial 7 Lawn and garden only 10 Monitoring well
 Was a chemical/bacteriological sample submitted to Department? Yes No X; If yes, mo/day/yr sample was submitted
 Water Well Disinfected? Yes No X

5 TYPE OF BLANK CASING USED: 5 Wrought iron 8 Concrete tile CASING JOINTS: Glued Clamped
 1 Steel 3 RMP (SR) 6 Asbestos-Cement 9 Other (specify below) Welded X
 2 PVC 4 ABS 7 Fiberglass Threaded
 Blank casing diameter 16 in. to 42 ft., Dia 16 in. to 66 ft., Dia in. to ft.
 Casing height above land surface 12 in., weight 36.87 lbs./ft. Wall thickness or gauge No. .219
 TYPE OF SCREEN OR PERFORATION MATERIAL: 7 PVC 10 Asbestos-cement
 1 Steel 3 Stainless steel 5 Fiberglass 8 RMP (SR) 11 Other (specify)
 2 Brass 4 Galvanized steel 6 Concrete tile 9 ABS 12 None used (open hole)
 SCREEN OR PERFORATION OPENINGS ARE: 5 Gauzed wrapped 8 Saw cut 11 None (open hole)
 1 Continuous slot 3 Mill slot 6 Wire wrapped 9 Drilled holes
 2 Louvered shutter 4 Key punched 7 Torch cut 10 Other (specify) Bridge Slot
 SCREEN-PERFORATED INTERVALS: From 42 ft. to 62 ft., From ft. to ft.
 From 66 ft. to 74 ft., From ft. to ft.
 GRAVEL PACK INTERVALS: From 20 ft. to 74 ft., From ft. to ft.
 From ft. to ft., From ft. to ft.

6 GROUT MATERIAL: 1 Neat cement 2 Cement grout 3 Bentonite 4 Other
 Grout Intervals: From 0 ft. to 20 ft., From ft. to ft., From ft. to ft.
 What is the nearest source of possible contamination: 10 Livestock pens 14 Abandoned water well
 1 Septic tank 4 Lateral lines 7 Pit privy 11 Fuel storage 15 Oil well/Gas well
 2 Sewer lines 5 Cess pool 8 Sewage lagoon 12 Fertilizer storage 16 Other (specify below)
 3 Watertight sewer lines 6 Seepage pit 9 Feedyard 13 Insecticide storage NONE KNOWN

Direction from well? How many feet?

FROM	TO	LITHOLOGIC LOG	FROM	TO	PLUGGING INTERVALS
0	2	Topsoil, Sandy Clay			
2	30	Brown Clay, Sandy			
30	42	Sand and Sandy Clay, Streaks of Gravel			
42	60	Sand and Gravel, Fine, Medium, Coarse			
60	69	Clay, Tan with Caliche			
69	74	Sand & Gravel, Medium			
74		Clay			

7 CONTRACTOR'S OR LANDOWNER'S CERTIFICATION: This water well was (1) constructed, (2) reconstructed, or (3) plugged under my jurisdiction and was completed on (mo/day/year) 12-7-89 and this record is true to the best of my knowledge and belief. Kansas Water Well Contractor's License No. 185 This Water Well Record was completed on (mo/day/yr) 3/29/91 under the business name of Clarke Well & Equipment, Inc. by (signature) *David W. Clarke*

OFFICE USE ONLY
T
R
EW
SEC.
1/4
1/4
1/4