


1 LOCATION OF WATER WELL: County: Pratt	Fraction Near the Center 1/4 1/4 SW 1/4	Section Number 14	Township Number T 26 S	Range Number R 13 E/W
--	--	----------------------	---------------------------	--------------------------

Distance and direction from nearest town or city street address of well if located within city?
Approximately 3 1/4 miles north and 1/4 mile east of Iuka

2 WATER WELL OWNER: Louis A. Griffith, Jr.
RR#, St. Address, Box #: Route 1
City, State, ZIP Code: Iuka, KS 67066
Board of Agriculture, Division of Water Resources
Application Number: 27,819

3 LOCATE WELL'S LOCATION WITH AN "X" IN SECTION BOX:

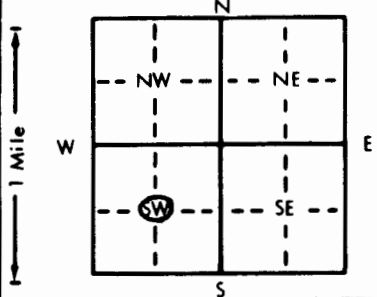

4 DEPTH OF COMPLETED WELL: 116 ft. ELEVATION: unknown
Depth(s) Groundwater Encountered: 1. ft. 2. ft. 3. ft.
WELL'S STATIC WATER LEVEL: 26.5 ft. below land surface measured on mo/day/yr 3-18-92
Pump test data: Well water was not ch'd. ft. after hours pumping gpm
Est. Yield unknown gpm: Well water was ft. after hours pumping gpm
Bore Hole Diameter: .24 in. to .115 ft., and in. to ft.
WELL WATER TO BE USED AS:
5 Public water supply 8 Air conditioning 11 Injection well
1 Domestic 3 Feedlot 6 Oil field water supply 9 Dewatering 12 Other (Specify below)
2 Irrigation 4 Industrial 7 Lawn and garden only 10 Monitoring well
Was a chemical/bacteriological sample submitted to Department? Yes No X; If yes, mo/day/yr sample was submitted
Water Well Disinfected? Yes No X

5 TYPE OF BLANK CASING USED:
1 Steel 3 RMP (SR) 5 Wrought iron 8 Concrete tile CASING JOINTS: Glued Clamped
2 PVC 4 ABS 6 Asbestos-Cement 9 Other (specify below) Welded X
7 Fiberglass Threaded
Blank casing diameter: .16 in. to .52 ft., Dia .16 in. to .87 ft., Dia in. to ft.
Casing height above land surface: .12 in., weight .42.05 lbs./ft. Wall thickness or gauge No. .250
TYPE OF SCREEN OR PERFORATION MATERIAL:
1 Steel 3 Stainless steel 5 Fiberglass 7 PVC 10 Asbestos-cement
2 Brass 4 Galvanized steel 6 Concrete tile 8 RMP (SR) 11 Other (specify)
9 ABS 12 None used (open hole)
SCREEN OR PERFORATION OPENINGS ARE:
1 Continuous slot 3 Mill slot 5 Gauzed wrapped 8 Saw cut 11 None (open hole)
2 Louvered shutter 4 Key punched 6 Wire wrapped 9 Drilled holes
7 Torch cut 10 Other (specify) . Bridge slot
SCREEN-PERFORATED INTERVALS: From .52 ft. to .64 ft., From ft. to ft.
From .87 ft. to .115 ft., From ft. to ft.
GRAVEL PACK INTERVALS: From .21 ft. to .115 ft., From ft. to ft.
From ft. to ft., From ft. to ft.

6 GROUT MATERIAL: 1 Neat cement 2 Cement grout 3 Bentonite 4 Other
Grout Intervals: From .0 ft. to .21 ft., From ft. to ft., From ft. to ft.
What is the nearest source of possible contamination:
1 Septic tank 4 Lateral lines 7 Pit privy 10 Livestock pens 14 Abandoned water well
2 Sewer lines 5 Cess pool 8 Sewage lagoon 11 Fuel storage 15 Oil well/Gas well
3 Watertight sewer lines 6 Seepage pit 9 Feedyard 12 Fertilizer storage 16 Other (specify below)
13 Insecticide storage . . None known
Direction from well? How many feet?

FROM	TO	LITHOLOGIC LOG	FROM	TO	PLUGGING INTERVALS
0	3	Topsoil			
3	9	Clay, red			
9	16	Sand and gravel, fine			
16	24	Clay, brown			
24	38	Sand and gravel, very fine, fine			
38	50	Gravel, medium, coarse			
50	51	Clay, tan			
51	62	Sand and gravel, fine, some medium			
62	85	Clay, tan and brown			
85	93	Sand and gravel, fine, medium			
93	115	Sand and gravel, meidum to coarse			

7 CONTRACTOR'S OR LANDOWNER'S CERTIFICATION: This water well was (1) constructed, (2) reconstructed, or (3) plugged under my jurisdiction and was completed on (mo/day/year) 3-18-92 and this record is true to the best of my knowledge and belief. Kansas Water Well Contractor's License No. 185 This Water Well Record was completed on (mo/day/yr) 4-6-92 under the business name of Clarke Well & Equipment, Inc. by (signature) *Charles W. Clarke*

INSTRUCTIONS: Use typewriter or ball point pen. PLEASE PRESS FIRMLY and PRINT clearly. Please fill in blanks, underline or circle the correct answers. Send top three copies to Kansas Department of Health and Environment, Bureau of Water, Topeka, Kansas 66620-0001. Telephone: 913-296-5545. Send one to WATER WELL OWNER and retain one for your records.

OFFICE USE ONLY
T
R
EW
SEC.
1/4
1/4
1/4