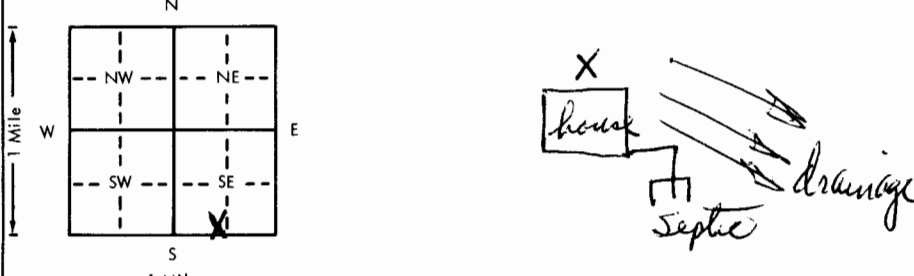


USE TYPEWRITER OR BALL
POINT PEN-PRESS FIRMLY,
PRINT CLEARLY.

WATER WELL RECORD
KSA 82a-1201-1215

Kansas Department of Health and
Environment-Division of Environment
(Water well Contractors)
Topeka, Kansas 66620

1. Location of well:	County <u>Pratt</u>	Fraction <u>SE 1/4 SW 1/4 SE 1/4</u>	Section number <u>19</u>	Township number <u>T 26 S</u>	Range number <u>R 13 W E/W</u>
2. Distance and direction from nearest town or city: <u>2 N & 2 1/4 W</u>		3. Owner of well: <u>Roger McManis</u>			
Street address of well location if in city: <u>of Iuka</u>		R.R. or street: <u>Iuka, Ks</u>			
City, state, zip code: <u>Iuka, Ks</u>					
4. Locate with "X" in section below:		Sketch map:		6. Bore hole dia. <u>10</u> in. Completion date <u>28 Apr 78</u>	
				Well depth <u>110</u> ft.	
5. Type and color of material		From	To	7. <input checked="" type="checkbox"/> Cable tool <input checked="" type="checkbox"/> Rotary <input type="checkbox"/> Driven <input type="checkbox"/> Dug	
Soil, sandy		0	3	<input type="checkbox"/> Hollow rod <input type="checkbox"/> Jetted <input type="checkbox"/> Bored <input type="checkbox"/> Reverse rotary	
Sand, fine		3	16	8. Use: <input checked="" type="checkbox"/> Domestic <input type="checkbox"/> Public supply <input type="checkbox"/> Industry	
Clay, tan, sandy		16	28	<input type="checkbox"/> Irrigation <input type="checkbox"/> Air conditioning <input type="checkbox"/> Stock	
Sand, fine		28	37	<input type="checkbox"/> Lawn <input type="checkbox"/> Oil field water <input type="checkbox"/> Other	
Sand, fine to coarse and gravel		37	59	9. Casing: Material <u>Steel</u> Height <u>Above</u> or below	
Clay, green		59	63	Threaded <input type="checkbox"/> Welded <input type="checkbox"/> Surface <u>12</u> in.	
Sand, fine to coarse and med. gravel		63	90	RMP <u>5</u> PVC <input checked="" type="checkbox"/> Weight <u>12</u> lbs./ft.	
Clay, tan and white		90	100	Dia. <u>5</u> in. to <u>70</u> ft. depth Wall Thickness: inches or	
Sand, fine to coarse and med. to coarse gravel		100	120	Dia. <u>5</u> in. to <u>70</u> ft. depth gage No. <u>258</u>	
				10. Screen: Manufacturer's name <u>Peerless</u>	
				Type <u>Slot</u> Dia. <u>5</u> in.	
				Slot/gauze <u>1/8</u> Length <u>30</u> ft.	
				Set between <u>70</u> ft. and <u>90</u> ft.	
				<u>100</u> ft. and <u>110</u> ft.	
				Gravel pack? <input checked="" type="checkbox"/> Size range of material <u>1/8 X 1/4</u>	
				11. Static water level: <u>37</u> ft. below land surface Date <u>28 Apr 78</u>	
				12. Pumping level below land surfaces:	
				<u>37</u> ft. after <u>1</u> hrs. pumping <u>50</u> g.p.m.	
				<u>50</u> ft. after <u>1</u> hrs. pumping <u>50</u> g.p.m.	
				Estimated maximum yield <u>50</u> g.p.m.	
				13. Water sample submitted: <u>Yes</u> <input checked="" type="checkbox"/> No <input type="checkbox"/> Date <u>28 Apr 78</u>	
				14. Well head completion:	
				<input checked="" type="checkbox"/> Pitless adapter <u>12</u> inches above grade	
				15. Well grouted? <input checked="" type="checkbox"/>	
				With: <input checked="" type="checkbox"/> Neat cement <input type="checkbox"/> Bentonite <input type="checkbox"/> Concrete	
				Depth: From <u>4</u> ft. to <u>14</u> ft.	
				16. Nearest source of possible contamination:	
				ft. <u>80</u> Direction <u>SE</u> Type <u>Septic</u>	
				Well disinfected upon completion? <input checked="" type="checkbox"/> Yes <input type="checkbox"/> No	
				17. Pump:	
				Not installed	
				Manufacturer's name <u>SPRITE</u>	
				Model number <u>SR 20</u> HP <u>1</u> Volts <u>230</u>	
				Length of drop pipe <u>100</u> ft. capacity <u>25</u> g.p.m.	
				Type:	
				<input checked="" type="checkbox"/> Submersible <input type="checkbox"/> Turbine	
				<input type="checkbox"/> Jet <input type="checkbox"/> Reciprocating	
				<input type="checkbox"/> Centrifugal <input type="checkbox"/> Other	
18. Elevation:		19. Remarks:		20. Water well contractor's certification:	
Topography:		<u>4'x4'x4" slot poured below pitless adapter</u>		This well was drilled under my jurisdiction and this report is true to the best of my knowledge and belief.	
<input type="checkbox"/> Hill				Central Well & Pump Svc. 325	
<input type="checkbox"/> Slope				Business name License No.	
<input checked="" type="checkbox"/> Upland				Address <u>121 S. Taylor Pratt, Ks.</u>	
<input type="checkbox"/> Valley				Signed <u>Robert M. Smith</u> Date <u>April 78</u>	
				Authorized representative	

Forward the white, blue and pink copies to the Department of Health and Environment

Form WWC-5