


BECKER #6

1 LOCATION OF WATER WELL: Fraction SW 1/4 SW 1/4 NE 1/4 Section Number 33 Township Number T 26 S Range Number R 13 EW
 County: PRATT
 Distance and direction from nearest town or city street address of well if located within city?

IUKA 1/2 N WESTSIDE.

2 WATER WELL OWNER: COUGAR DRILLING CO. INC
 RR#, St. Address, Box #: 555 N. WOODLAWN SUITE 114
 City, State, ZIP Code: WICHITA, K.S. 67208
 Board of Agriculture, Division of Water Resources
 Application Number: T85-706

3 LOCATE WELL'S LOCATION WITH AN "X" IN SECTION BOX: 4 DEPTH OF COMPLETED WELL: 115 ft. ELEVATION: 103 ft.

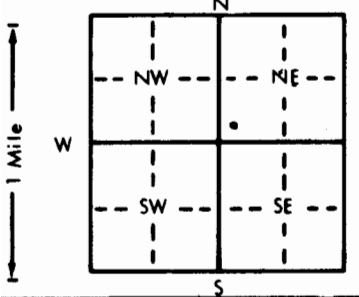

Depth(s) Groundwater Encountered 1. 95 ft. 2. 103 ft. 3. 103 ft.
 WELL'S STATIC WATER LEVEL 50 ft. below land surface measured on mo/day/yr 8-2-85
 WELL WATER TO BE USED AS:
 1 Domestic 3 Feedlot 6 Oil field water supply 9 Dewatering 12 Other (Specify below)
 2 Irrigation 4 Industrial 7 Lawn and garden only 10 Observation well
 Was a chemical/bacteriological sample submitted to Department? Yes.....No.....; If yes, mo/day/yr sample was submitted
 Water Well Disinfected? Yes No

5 TYPE OF CASING USED: 1 Steel 3 RMP (SR) 5 Wrought iron 8 Concrete tile CASING JOINTS: Glued XX Clamped.....
 2 PVC 4 ABS 6 Asbestos-Cement 9 Other (specify below) Welded.....
 7 Fiberglass Threaded.....

 Casing height above land surface 12 in., weight 2.65 lbs./ft. Wall thickness or gauge No. 214

TYPE OF SCREEN OR PERFORATION MATERIAL:
 1 Steel 3 Stainless steel 5 Fiberglass 7 PVC 10 Asbestos-cement
 2 Brass 4 Galvanized steel 6 Concrete tile 8 RMP (SR) 11 Other (specify).....
 12 None used (open hole)

SCREEN OR PERFORATION OPENINGS ARE: 1/8
 1 Continuous slot 3 Mill slot 5 Gauzed wrapped 8 Saw cut 11 None (open hole)
 2 Louvered shutter 4 Key punched 6 Wire wrapped 9 Drilled holes
 7 Torch cut 10 Other (specify).....

SCREEN-PERFORATED INTERVALS: From 95 ft. to 115 ft., From ft. to ft.
 GRAVEL PACK INTERVALS: From 85 ft. to 115 ft., From ft. to ft.

6 GROUT MATERIAL: 1 Neat cement 2 Cement grout 3 Bentonite 4 Other.....
 Grout Intervals: From 0 ft. to 10 ft., From ft. to ft., From ft. to ft.

What is the nearest source of possible contamination: NONE
 1 Septic tank 4 Lateral lines 7 Pit privy 10 Livestock pens 14 Abandoned water well
 2 Sewer lines 5 Cess pool 8 Sewage lagoon 11 Fuel storage 15 Oil well/Gas well
 3 Watertight sewer lines 6 Seepage pit 9 Feedyard 12 Fertilizer storage 16 Other (specify below)
 13 Insecticide storage

Direction from well? How many feet?

FROM	TO	LITHOLOGIC LOG	FROM	TO	LITHOLOGIC LOG
0	4	TOP SOIL			
4	40	CLAY			
40	60	SANDY CLAY			
60	70	CLAY			
70	85	SANDY CLAY			
85	100	GRAVEL			
100	103	CLAY			
103	113	GRAVEL			
113	115	CLAY			

7 CONTRACTOR'S OR LANDOWNER'S CERTIFICATION: This water well was (1) constructed, (2) reconstructed, or (3) plugged under my jurisdiction and was completed on (mo/day/year) 8-2-85 and this record is true to the best of my knowledge and belief. Kansas Water Well Contractor's License No. 389 This Water Well Record was completed on (mo/day/yr) 8-12-85

under the business name of REISER WATER WELL SERV. INC. by (signature) Rudolph J. Reiser
 INSTRUCTIONS: Use typewriter or ball point pen, PLEASE PRESS FIRMLY and PRINT clearly. Please fill in blanks, underline or circle the correct answers. Send top three copies to Kansas Department of Health and Environment, Division of Environment, Environmental Geology Section, Topeka, KS 66620. Send one to WATER WELL OWNER and retain one for your records.

OFFICE USE ONLY T R E W SEC.