

BELKER #5


1 LOCATION OF WATER WELL: County: PRATT	Fraction SE 1/4 NW 1/4 NE 1/4	Section Number 33	Township Number T 26 S	Range Number R 13 E
---	---	-----------------------------	----------------------------------	-------------------------------

Distance and direction from nearest town or city street address of well if located within city?

1/4 MI IN NW SOUTHSIDE

2 WATER WELL OWNER: RR#, St. Address, Box # : City, State, ZIP Code :	COUGAR DRILLING CO. INC. 555 N. WOODLAWN SUITE 114 WICHITA, KS 67208	Board of Agriculture, Division of Water Resources Application Number: T85-707
---	---	---

3 LOCATE WELL'S LOCATION WITH AN "X" IN SECTION BOX:	4 DEPTH OF COMPLETED WELL: 115 ft. ELEVATION:
--	--

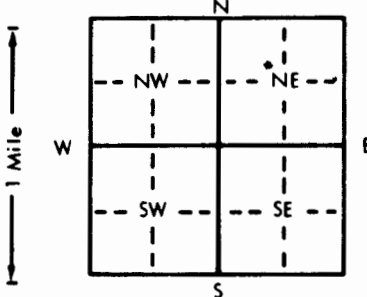

Depth(s) Groundwater Encountered 1. **56** ft. 2. **77** ft. 3. _____ ft.

WELL'S STATIC WATER LEVEL **49** ft. below land surface measured on **7-25-85** mo/day/yr

Pump test data: Well water was _____ ft. after _____ hours pumping _____ gpm

Est. Yield _____ gpm; Well water was _____ ft. after _____ hours pumping _____ gpm

Bore Hole Diameter **7 7/8** in. to **11 1/2** in. and _____ in. to _____ in.

WELL WATER TO BE USED AS:

5 Public water supply	8 Air conditioning	11 Injection well
1 Domestic	3 Feedlot	6 Oil field water supply
2 Irrigation	4 Industrial	7 Lawn and garden only
		9 Dewatering
		10 Observation well
		12 Other (Specify below)

Was a chemical/bacteriological sample submitted to Department? Yes _____ No _____; If yes, mo/day/yr sample was submitted _____

Water Well Disinfected? Yes _____ No _____

5 TYPE OF BLANK CASING USED:	5 Wrought iron	8 Concrete tile	CASING JOINTS: Glued <input checked="" type="checkbox"/> Clamped _____
1 Steel	3 RMP (SR)	6 Asbestos-Cement	9 Other (specify below)
2 PVC	4 ABS	7 Fiberglass	Welded _____
Blank casing diameter _____ in. to _____ in.	_____ ft., Dia _____ ft., Dia _____ in. to _____ in.		Threaded _____

Blank casing height above land surface _____ in., weight _____ lbs./ft. Wall thickness or gauge No. **214**

TYPE OF SCREEN OR PERFORATION MATERIAL:	7 PVC	10 Asbestos-cement
1 Steel	3 Stainless steel	5 Fiberglass
2 Brass	4 Galvanized steel	6 Concrete tile
		8 RMP (SR)
		9 ABS
		11 Other (specify) _____
		12 None used (open hole)

SCREEN OR PERFORATION OPENINGS ARE: **1/8**

1 Continuous slot	3 Mill slot	5 Gauzed wrapped	8 Saw cut	11 None (open hole)
2 Louvered shutter	4 Key punched	6 Wire wrapped	9 Drilled holes	
		7 Torch cut	10 Other (specify) _____	

SCREEN-PERFORATED INTERVALS: From **95** ft. to **115** ft., From _____ ft. to _____ ft.

GRAVEL PACK INTERVALS: From **85** ft. to **115** ft., From _____ ft. to _____ ft.

6 GROUT MATERIAL:	1 Neat cement	2 Cement grout	3 Bentonite	4 Other _____
-------------------	---------------	----------------	-------------	---------------

Grout intervals: From **0** ft. to **10** ft., From _____ ft. to _____ ft., From _____ ft. to _____ ft.

What is the nearest source of possible contamination: **NONE**

1 Septic tank	4 Lateral lines	7 Pit privy	10 Livestock pens	14 Abandoned water well
2 Sewer lines	5 Cess pool	8 Sewage lagoon	11 Fuel storage	15 Oil well/Gas well
3 Watertight sewer lines	6 Seepage pit	9 Feedyard	12 Fertilizer storage	16 Other (specify below)
			13 Insecticide storage	

Direction from well? _____ How many feet? _____

FROM	TO	LITHOLOGIC LOG	FROM	TO	LITHOLOGIC LOG
0	2	TOP SOIL			
2	20	CLAY			
20	25	FINE SAND			
25	30	SANDY CLAY			
30	55	CLAY			
55	75	GRAVEL			
75	77	CLAY			
77	85	GRAVEL			
85	87	CLAY			
87	115	GRAVEL			

7 CONTRACTOR'S OR LANDOWNER'S CERTIFICATION: This water well was (1) <u>constructed</u> , (2) reconstructed, or (3) plugged under my jurisdiction and was completed on (mo/day/year) 7-25-85 and this record is true to the best of my knowledge and belief. Kansas Water Well Contractor's License No. 389 This Water Well Record was completed on (mo/day/yr) 7-28-85 under the business name of RELSEY WATER WELL SERV. INC. by (signature) <i>Rudolph J. Pauer</i>
--

INSTRUCTIONS: Use typewriter or ball point pen, PLEASE PRESS FIRMLY and PRINT clearly. Please fill in blanks, underline or circle the correct answers. Send top three copies to Kansas Department of Health and Environment, Division of Environment, Environmental Geology Section, Topeka, KS 66620. Send one to WATER WELL OWNER and retain one for your records.

OFFICE USE ONLY
T
R
EW
SEC.
1/4
1/4
1/4