


1 LOCATION OF WATER WELL: County: <b>Pratt</b>	Fraction <b>SW 1/4 NE 1/4 SW 1/4</b>	Section Number <b>33</b>	Township Number <b>T 26 S</b>	Range Number <b>R 13W EW</b>
---------------------------------------------------	-----------------------------------------	-----------------------------	----------------------------------	---------------------------------

Distance and direction from nearest town or city street address of well if located within city?  
1/2 W, 1/2 N of Iuka, Kansas

2 WATER WELL OWNER: <b>George Lemmon</b> RR#, St. Address, Box #: <b>Route 2</b> City, State, ZIP Code: <b>Pratt, Ks. 67124</b>	<b>Graves Drilling</b> <b>910 Union Center</b> <b>Wichita, Kansas 67202</b>	<b>Lemmon #5</b> <b>T85-929</b> Board of Agriculture, Division of Water Resources Application Number: <b>Unknown</b>
---	-----------------------------------------------------------------------------------	---

3 LOCATE WELL'S LOCATION WITH AN "X" IN SECTION BOX:	4 DEPTH OF COMPLETED WELL: <b>110</b> ft. ELEVATION: <b>Unknown</b>
------------------------------------------------------	---------------------------------------------------------------------

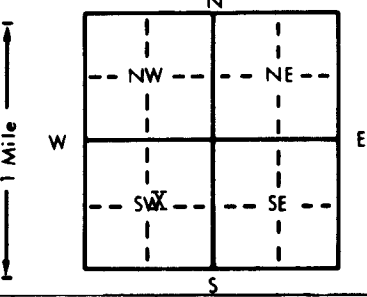

Depth(s) Groundwater Encountered 1. **55** ft. 2. \_\_\_\_\_ ft. 3. \_\_\_\_\_ ft.

WELL'S STATIC WATER LEVEL **55** ft. below land surface measured on mo/day/yr **10/26/85**

Pump test data: Well water was \_\_\_\_\_ ft. after \_\_\_\_\_ hours pumping \_\_\_\_\_ gpm

Est. Yield **60** gpm: Well water was \_\_\_\_\_ ft. after \_\_\_\_\_ hours pumping \_\_\_\_\_ gpm

Bore Hole Diameter **8** in. to **110** ft., and \_\_\_\_\_ in. to \_\_\_\_\_ ft.

WELL WATER TO BE USED AS:

5 Public water supply	8 Air conditioning	11 Injection well
1 Domestic	3 Feedlot	6 <u>Oil field water supply</u>
2 Irrigation	4 Industrial	7 Lawn and garden only
		10 Observation well

9 Dewatering  
12 Other (Specify below)

Was a chemical/bacteriological sample submitted to Department? Yes No; If yes, mo/day/yr sample was submitted \_\_\_\_\_

Water Well Disinfected? Yes No

5 TYPE OF BLANK CASING USED:	5 Wrought iron	8 Concrete tile	CASING JOINTS: <u>Glued</u>	Clamped
1 Steel	3 RMP (SR)	6 Asbestos-Cement	9 Other (specify below)	Welded
2 <u>PVC</u>	4 ABS	7 Fiberglass		Threaded

Blank casing diameter **5** in. to **90** ft., Dia \_\_\_\_\_ in. to \_\_\_\_\_ ft., Dia \_\_\_\_\_ in. to \_\_\_\_\_ ft.

Casing height above land surface **12** in., weight **2.8** lbs./ft. Wall thickness or gauge No. **Sch. 40**

TYPE OF SCREEN OR PERFORATION MATERIAL:	7 <u>PVC</u>	10 Asbestos-cement
1 Steel	3 Stainless steel	5 Fiberglass
2 Brass	4 Galvanized steel	6 Concrete tile
		8 RMP (SR)
		9 ABS
		11 Other (specify) _____
		12 None used (open hole)

SCREEN OR PERFORATION OPENINGS ARE:	5 Gauzed wrapped	8 <u>Saw cut</u>	11 None (open hole)
1 Continuous slot	3 Mill slot	6 Wire wrapped	9 Drilled holes
2 Louvered shutter	4 Key punched	7 Torch cut	10 Other (specify) _____

SCREEN-PERFORATED INTERVALS: From **90** ft. to **110** ft., From \_\_\_\_\_ ft. to \_\_\_\_\_ ft.

GRAVEL PACK INTERVALS: From **10** ft. to **110** ft., From \_\_\_\_\_ ft. to \_\_\_\_\_ ft.

6 GROUT MATERIAL:	<u>1 Neat cement</u>	2 Cement grout	3 Bentonite	4 Other _____
-------------------	----------------------	----------------	-------------	---------------

Grout Intervals: From **0** ft. to **10** ft., From \_\_\_\_\_ ft. to \_\_\_\_\_ ft., From \_\_\_\_\_ ft. to \_\_\_\_\_ ft.

What is the nearest source of possible contamination:

1 Septic tank	4 Lateral lines	7 Pit privy	11 Fuel storage	14 Abandoned water well
2 Sewer lines	5 Cess pool	8 Sewage lagoon	12 Fertilizer storage	15 <u>Oil well/Gas well</u>
3 Watertight sewer lines	6 Seepage pit	9 Feedyard	13 Insecticide storage	16 Other (specify below)

Direction from well? **South** How many feet? **60**

FROM	TO	LITHOLOGIC LOG	FROM	TO	LITHOLOGIC LOG
0	39	Clay			
39	110	Sand and gravel			

7 CONTRACTOR'S OR LANDOWNER'S CERTIFICATION: This water well was (1) constructed, (2) reconstructed, or (3) plugged under my jurisdiction and was completed on (mo/day/year) **10/26/85** and this record is true to the best of my knowledge and belief, Kansas Water Well Contractor's License No. **186** This Water Well Record was completed on (mo/day/yr) **11/30/85** under the business name of **Kelly's Water Well Service** by (signature) *[Signature]*

INSTRUCTIONS: Use typewriter or ball point pen, PLEASE PRESS FIRMLY and PRINT clearly. Please fill in blanks, underline or circle the correct answers. Send top three copies to Kansas Department of Health and Environment, Division of Environment, Environmental Geology Section, Topeka, KS 66620. Send one to WATER WELL OWNER and retain one for your records.

OFFICE USE ONLY T R EW SEC. 1/4 1/4 1/4 1/4