


1 LOCATION OF WATER WELL: County: Pratt	Fraction SW 1/4 NW 1/4 SW 1/4	Section Number 33	Township Number T 26 S	Range Number R 13W EW
---	---	-----------------------------	----------------------------------	---------------------------------

Distance and direction from nearest town or city street address of well if located within city?

1/2 W, 1/2 N of Iuka, Kansas

2 WATER WELL OWNER: George Lemmon	Graves Drilling	Lemmon #4
RR#, St. Address, Box #: Route 2	910 Union Center	Board of Agriculture, Division of Water Resources
City, State, ZIP Code: Pratt, Ks. 67124	Wichita, Kansas 67202	Application Number: Unknown

3 LOCATE WELL'S LOCATION WITH AN "X" IN SECTION BOX:	4 DEPTH OF COMPLETED WELL: 110 ft. ELEVATION: Unknown
--	---

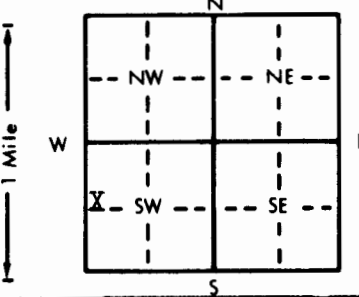

Depth(s) Groundwater Encountered 1. **55** ft. 2. _____ ft. 3. _____ ft.

WELL'S STATIC WATER LEVEL: **55** ft. below land surface measured on mo/day/yr **10/26/85**

Pump test data: Well water was _____ ft. after _____ hours pumping _____ gpm

Est. Yield **60** gpm: Well water was _____ ft. after _____ hours pumping _____ gpm

Bore Hole Diameter: **8** in. to **110** ft., and _____ in. to _____ ft.

WELL WATER TO BE USED AS:

5 Public water supply	8 Air conditioning	11 Injection well
1 Domestic	3 Feedlot	6 <u>Oil field water supply</u>
2 Irrigation	4 Industrial	7 Lawn and garden only
		10 Observation well

Was a chemical/bacteriological sample submitted to Department? Yes _____ No _____; If yes, mo/day/yr sample was submitted _____

Water Well Disinfected? Yes _____ No _____

5 TYPE OF BLANK CASING USED:	5 Wrought iron	8 Concrete tile	CASING JOINTS: <u>Glued</u>
1 Steel	3 RMP (SR)	9 Other (specify below)	Clamped _____
2 <u>PVC</u>	4 ABS	7 Fiberglass	Welded _____
			Threaded _____

Blank casing diameter **5** in. to **90** ft., Dia _____ in. to _____ ft., Dia _____ in. to _____ ft.

Casing height above land surface **12** in., weight **2.8** lbs./ft. Wall thickness or gauge No. **Sch. 40**

TYPE OF SCREEN OR PERFORATION MATERIAL:	7 <u>PVC</u>	10 Asbestos-cement
1 Steel	3 Stainless steel	5 Fiberglass
2 Brass	4 Galvanized steel	6 Concrete tile
		8 RMP (SR)
		9 ABS
		11 Other (specify) _____
		12 None used (open hole)

SCREEN OR PERFORATION OPENINGS ARE:	5 Gauzed wrapped	8 <u>Saw cut</u>	11 None (open hole)
1 Continuous slot	3 Mill slot	6 Wire wrapped	9 Drilled holes
2 Louvered shutter	4 Key punched	7 Torch cut	10 Other (specify) _____

SCREEN-PERFORATED INTERVALS: From **90** ft. to **110** ft., From _____ ft. to _____ ft.

GRAVEL PACK INTERVALS: From **10** ft. to **110** ft., From _____ ft. to _____ ft.

6 GROUT MATERIAL:	1 <u>Neat cement</u>	2 Cement grout	3 Bentonite	4 Other _____
-------------------	----------------------	----------------	-------------	---------------

Grout Intervals: From **0** ft. to **10** ft., From _____ ft. to _____ ft., From _____ ft. to _____ ft.

What is the nearest source of possible contamination:

1 Septic tank	4 Lateral lines	7 Pit privy	10 Livestock pens	14 Abandoned water well
2 Sewer lines	5 Cess pool	8 Sewage lagoon	11 Fuel storage	15 <u>Oil well/Gas well</u>
3 Watertight sewer lines	6 Seepage pit	9 Feedyard	12 Fertilizer storage	16 Other (specify below)
			13 Insecticide storage	

Direction from well? South How many feet? **60**

FROM	TO	LITHOLOGIC LOG	FROM	TO	LITHOLOGIC LOG
0	38	Clay			
38	110	Sand and gravel			

7 CONTRACTOR'S OR LANDOWNER'S CERTIFICATION: This water well was (1) constructed, (2) reconstructed, or (3) plugged under my jurisdiction and was completed on (mo/day/year) **10/26/85** and this record is true to the best of my knowledge and belief, Kansas Water Well Contractor's License No. **186**. This Water Well Record was completed on (mo/day/yr) **11/30/85** under the business name of Kelly's Water Well Service by (signature) [Signature]

INSTRUCTIONS: Use typewriter or ball point pen, PLEASE PRESS FIRMLY and PRINT clearly. Please fill in blanks, underline or circle the correct answers. Send top three copies to Kansas Department of Health and Environment, Division of Environment, Environmental Geology Section, Topeka, KS 66620. Send one to WATER WELL OWNER and retain one for your records.

OFFICE USE ONLY
T
R
EW
SEC.
1/4
1/4
1/4