

WATER WELL RECORD

Form WWC-5

Division of Water Resources App. No.


16042

1 LOCATION OF WATER WELL: Fraction 1/4 NC 1/4 SE 1/4 Section Number 11 Township No. T 26 S Range Number R 14 E W
 County: Pratt

Street/Rural Address of Well Location; if unknown, distance & direction from nearest town or intersection: If at owner's address, check here
 Approximately 0.5 miles north and 3 miles east of Byers.

Global Positioning System (GPS) information:
 Latitude: 37.795856 (in decimal degrees)
 Longitude: -98.817142 (in decimal degrees)
 Elevation: unknown
 Datum: WGS 84, NAD 83, NAD 27
 Collection Method:
 GPS unit (Make/Model: WAAS)
 Digital Map/Photo, Topographic Map, Land Survey
 Est. Accuracy: <3 m, 3-5 m, 5-15 m, >15 m

2 WATER WELL OWNER: Bob Moore
 RR#, Street Address, Box #: 100232 NW 40th Ave.
 City, State, ZIP Code : luka, KS 67066

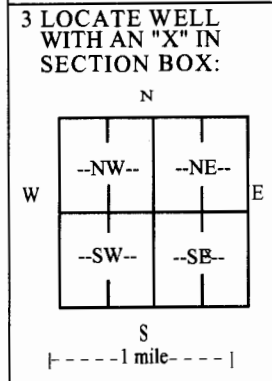

4 DEPTH OF COMPLETED WELL 144.50 ft.
 Depth(s) Groundwater Encountered (1) _____ ft. (2) _____ ft. (3) _____ ft.
 WELL'S STATIC WATER LEVEL 26.50 ft. below land surface measured on mo/day/yr 11/22/11
 Pump test data: Well water was Not checked ft. after _____ hours pumping _____ gpm
 EST. YIELD _____ gpm. Well water was _____ ft. after _____ hours pumping _____ gpm
 Bore Hole Diameter 24 in. to 145 ft., and _____ in. to _____ ft.
 WELL WATER TO BE USED AS: Public water supply Geothermal Injection well
 Domestic Feedlot Oil field water supply Dewatering Other (Specify below)
 Irrigation Industrial Domestic-lawn & garden Monitoring well
 Was a chemical/bacteriological sample submitted to Department? Yes No
 If yes, mo/day/yr sample was submitted _____
 Water well disinfected? Yes No

5 TYPE OF CASING USED: Steel PVC Other
 CASING JOINTS: Glued Clamped Welded Threaded
 Casing diameter 24 in. to 61 ft., Diameter 24 in. to 78 ft., Diameter 24 in. to 111 ft.
 Casing height above land surface 18 in., Weight 19.75 lbs./ft., Wall thickness or gauge No. 616
 TYPE OF SCREEN OR PERFORATION MATERIAL:
 Steel Stainless Steel PVC Other (Specify) _____
 Brass Galvanized Steel None used (open hole)
 SCREEN OR PERFORATION OPENINGS ARE:
 Continuous slot Mill slot Gauze wrapped Torch cut Drilled holes None (open hole)
 Louvered shutter Key punched Wire wrapped Saw cut Other (specify) _____
 SCREEN-PERFORATED INTERVALS: From 61 ft. to 71 ft., From 111 ft. to 143 ft.
 From 78 ft. to 93 ft., From _____ ft. to _____ ft.
 GRAVEL PACK INTERVALS: From 23 ft. to 145 ft., From _____ ft. to _____ ft.
 From _____ ft. to _____ ft., From _____ ft. to _____ ft.

6 GROUT MATERIAL: Neat cement Cement grout Bentonite Other
 Grout Intervals: From _____ ft. to _____ ft., From 3 ft. to 23 ft., From _____ ft. to _____ ft.
 What is the nearest source of possible contamination:
 Septic tank Lateral lines Pit privy Livestock pens Insecticide storage Other (specify below)
 Sewer lines Cesspool Sewage lagoon Fuel storage Abandoned water well
 Watertight sewer lines Seepage pit Feedyard Fertilizer storage Oil well/gas well None Known
 Direction from well _____ Distance from well _____

FROM	TO	LITHOLOGIC LOG	FROM	TO	LITHO. LOG (cont.) or PLUGGING INTERVALS
0	6	Topsoil	78	93	Sand, coarse to fine, with gravel, coarse to fine, clean
6	11	Clay, gray, hard			
11	17	Clay, brown, hard	93	95	Cement, sand, hard
17	34	Clay, tan & brown, sandy	95	98	Clay, tan, hard
34	37	Clay, brown, sandy	98	99	Cement, sand, hard
37	42	Clay, white, hard, sandy	99	111	Clay, brown, hard
42	53	Clay, brown, hard	111	122	Clay, brown, hard, sand, coarse to fine streaks
53	71	Sand, coarse to fine, with gravel, coarse to fine, clean	122	143	Sand, coarse to very fine, with brown clay streaks, 50/50 mix
71	78	Clay, tan, hard	143	145	Clay, brown, hard

7 CONTRACTOR'S OR LANDOWNER'S CERTIFICATION: This water well was constructed, reconstructed, or plugged under my jurisdiction and was completed on (mo/day/year) 11/22/11 and this record is true to the best of my knowledge and belief.
 Kansas Water Well Contractor's License No. 185 This Water Well Record was completed on (mo/day/year) 11/28/11
 under the business name of Clarke Well & Equipment, Inc. by (signature) _____

INSTRUCTIONS: Use typewriter or ball point pen. PLEASE PRESS FIRMLY and PRINT clearly. Please fill in blanks and check the correct answers. Send three copies (white, blue, pink) to Kansas Department of Health and Environment, Bureau of Water, Geology Section, 1000 SW Jackson St., Suite 420, Topeka, Kansas 66612-1367. Telephone 785-296-5522. Send one copy to WATER WELL OWNER and retain one for your records. Include fee of \$5.00 for each constructed well. Visit us at <http://www.kdheks.gov/waterwell/index.html>.