USE TYPEWRITER OR BALL POINT PEN-PRESS FIRMLY, PRINT CLEARLY.

WATER WELL RECORD
KSA 82a-1201-1215

Kansas Department of Health and Environment-Division of Environment
(Water well Contractors)
Topeka, Kansas 66620

1. Location of well:	County	Fraction	Section number	Township number	Range number
	Pratt	SW 1/4 NW 1/4 SW 1/4	3	T 26 S	R # 14W E/W

2. Distance and direction from nearest town or city: le 1¼n
Street address of well location if in city: Byers, Ks.

3. Owner of well: Woodman-Ianitti Drlg Co
R.R. or street: Box 308
City, state, zip code: Great Bend, Ks.

4. Locate with "X" in section below:

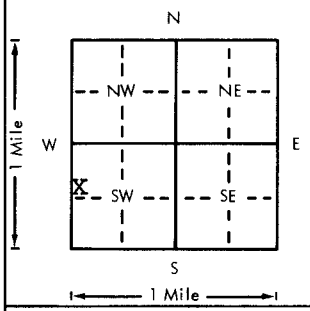

Sketch map:

6. Bore hole dia. 7 in. Completion date
Well depth 75 ft. 2-9-78

7. __ Cable tool X Rotary __ Driven __ Dug
__ Hollow rod __ Jetted __ Bored __ Reverse rotary

8. Use: __ Domestic __ Public supply __ Industry
__ Irrigation __ Air conditioning __ Stock
__ Lawn X Oil field water __ Other

9. Casing: Material
Threaded __ Welded __
RMP __ PVC X
Dia. 4 in. to 75 ft. depth
Dia. __ in. to __ ft. depth
Height: Above ~~XXXX~~ Surface 12 in.
Weight 2 lbs./ft.
Wall Thickness: inches or gage No. Sch 40

10. Screen: Manufacturer's name Jetstream
Type pvc Dia. 4"
Slot/gauze 1/16" Length 20'
Set between 55 ft. and 75 ft.
ft. and ft.
Gravel pack? X Size range of material 1/8-3/4"

11. Static water level: mo./day/yr.
16 ft. below land surface Date 2-9-78

12. Pumping level below land surfaces:
ft. after hrs. pumping g.p.m.
ft. after hrs. pumping g.p.m.
Estimated maximum yield 50 g.p.m.

13. Water sample submitted: mo./day/yr.
__ Yes X No Date

14. Well head completion:
__ Pitless adapter 12 Inches above grade

15. Well grouted? X
With: __ Neat cement X Bentonite __ Concrete
Depth: From 0 ft. to 10 ft.

16. Nearest source of possible contamination: Oil Test
ft. 60 Direction se Type
Well disinfected upon completion? __ Yes X No

17. Pump: X Not installed
Manufacturer's name
Model number HP Volts
Length of drop pipe ft. capacity g.p.m.
Type:
__ Submersible __ Turbine
__ Jet __ Reciprocating
__ Centrifugal __ Other

5. Type and color of material	From	To
Top Soil-Clay	0	16
Sandy Clay	16	35
Sand	35	50
Sand-Gravel	50	75

(Use a second sheet if needed)

18. Elevation:

Topography:
__ Hill
__ Slope
X Upland
__ Valley

19. Remarks:

20. Water well contractor's certification:
This well was drilled under my jurisdiction and this report is true to the best of my knowledge and belief.
Business name ~~Kellys Waterwell ser~~ License No. 186
Address R2 Great Bend, Ks.
Signed Kelly Price Date 8-30-79
Authorized representative

T 26 R 14 (E/W) Sec 3 1/4 SW 1/4 NW 1/4 SW 1/4

Forward the white, blue and pink copies to the Department of Health and Environment

Form WWC-5

MI-1023