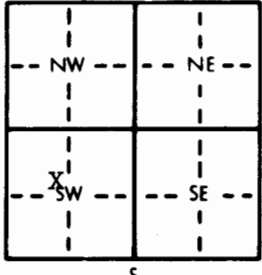


1 LOCATION OF WATER WELL: County: Pratt Fraction: SE 1/4 NW 1/4 SW 1/4 Section Number: 5 Township Number: T 26 S Range Number: R 14 E/W

Distance and direction from nearest town or city street address of well if located within city?
Approx. 1 1/2 mi. North and 3/4 mile west of Byers, KS

2 WATER WELL OWNER: Dwight Ellis
 RR#, St. Address, Box #: _____
 City, State, ZIP Code: Byers, KS 67021 Board of Agriculture, Division of Water Resources
 Application Number: 33,756


3 LOCATE WELL'S LOCATION WITH AN "X" IN SECTION BOX:  4 DEPTH OF COMPLETED WELL: 162 ft. ELEVATION: unknown
 Depth(s) Groundwater Encountered 1. 26 ft. 2. _____ ft. 3. _____ ft.
 WELL'S STATIC WATER LEVEL: 26 ft. below land surface measured on mo/day/yr 12/27/82
 Pump test data: Well water was not ok'd ft. after _____ hours pumping _____ gpm
 Est. Yield 1000 gpm: Well water was _____ ft. after _____ hours pumping _____ gpm
 Bore Hole Diameter: 24 in. to 162 ft., and _____ in. to _____ ft.
 WELL WATER TO BE USED AS:
 5 Public water supply 8 Air conditioning 11 Injection well
 1 Domestic 3 Feedlot 6 Oil field water supply 9 Dewatering 12 Other (Specify below)
2 Irrigation 4 Industrial 7 Lawn and garden only 10 Observation well
 Was a chemical/bacteriological sample submitted to Department? Yes _____ No X; If yes, mo/day/yr sample was submitted _____
 Water Well Disinfected? Yes _____ No X

5 TYPE OF BLANK CASING USED:
 1 Steel 3 RMP (SR) 5 Wrought iron 8 Concrete tile CASING JOINTS: Glued _____ Clamped _____
 2 PVC 4 ABS 6 Asbestos-Cement 9 Other (specify below) Welded XXX
 7 Fiberglass _____ Threaded _____
 Blank casing diameter: 16 in. to 94 in. Dia. _____ in. to _____ in. Dia. _____ in. to _____ in. Dia. _____ in. to _____ in. Dia.
 Casing height above land surface: 12 in., weight 42.05 lbs./ft. Wall thickness or gauge No. .250
 TYPE OF SCREEN OR PERFORATION MATERIAL:
 1 Steel 3 Stainless steel 5 Fiberglass 7 PVC 10 Asbestos-cement
 2 Brass 4 Galvanized steel 6 Concrete tile 8 RMP (SR) 11 Other (specify) _____
 9 ABS 12 None used (open hole)
 SCREEN OR PERFORATION OPENINGS ARE:
 1 Continuous slot 3 Mill slot 5 Gauzed wrapped 8 Saw cut 11 None (open hole)
 2 Louvered shutter 4 Key punched 6 Wire wrapped 9 Drilled holes
 7 Torch cut 10 Other (specify) Doerr Bridge Slot
 SCREEN-PERFORATED INTERVALS: From 94 ft. to 162 ft., From _____ ft. to _____ ft.
 From _____ ft. to _____ ft., From _____ ft. to _____ ft.
 GRAVEL PACK INTERVALS: From 10 ft. to 162 ft., From _____ ft. to _____ ft.
 From _____ ft. to _____ ft., From _____ ft. to _____ ft.

6 GROUT MATERIAL: 1 Neat cement 2 Cement grout 3 Bentonite 4 Other _____
 Grout Intervals: From 0 ft. to 10 ft., From _____ ft. to _____ ft., From _____ ft. to _____ ft.
 What is the nearest source of possible contamination:
 1 Septic tank 4 Lateral lines 7 Pit privy 10 Livestock pens 14 Abandoned water well
 2 Sewer lines 5 Cess pool 8 Sewage lagoon 11 Fuel storage 15 Oil well/Gas well
 3 Watertight sewer lines 6 Seepage pit 9 Feedyard 12 Fertilizer storage 16 Other (specify below)
 13 Insecticide storage _____ field

Direction from well? all How many feet? _____

FROM	TO	LITHOLOGIC LOG	FROM	TO	LITHOLOGIC LOG
0	45	Fine sand topsoil & sandy tan & white clay			
45	55	Sand & gravel, med. clean			
55	58	Soft sandy tan clay			
58	73	Sand & gravel, fine some med., clean w/a couple thin clay streaks			
73	92	Hard green & white clay			
92	123	Sand & gravel, fine, some med.-clean			
123	126	Very soft sandy brown clay			
126	161	Sand & gravel, med. to fine w/a few thin streaks of clay & cemented sand			
161	162	Brown clay			

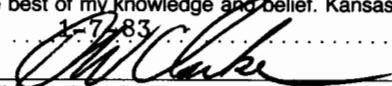7 CONTRACTOR'S OR LANDOWNER'S CERTIFICATION: This water well was (1) constructed, (2) reconstructed, or (3) plugged under my jurisdiction and was completed on (mo/day/year) 12/27/82 and this record is true to the best of my knowledge and belief. Kansas Water Well Contractor's License No. 185 This Water Well Record was completed on (mo/day/yr) 1-7-83 under the business name of CLARKE WELL & EQ., INC. by (signature) 

INSTRUCTIONS: Use typewriter or ball point pen, PLEASE PRESS FIRMLY and PRINT clearly. Please fill in blanks, underline or circle the correct answers. Send top three copies to Kansas Department of Health and Environment, Division of Environment, Environmental Geology Section, Topeka, KS 66620. Send one to WATER WELL OWNER and retain one for your records.

OFFICE USE ONLY T 210 R 14 EN SEC. 5 SE 1/4 NW 1/4 SW 1/4