


1 LOCATION OF WATER WELL: County: **Pratt** Fraction: **SW 1/4 SW 1/4 NW 1/4** Section Number: **10** Township Number: **T 26 S** Range Number: **R 14 EW**

Distance and direction from nearest town or city street address of well if located within city?
1 east 1/2 north & 125' east of Byers, Kansas

2 WATER WELL OWNER: **Double Arrow Farms**
 RR#, St. Address, Box #: **R. R.** Board of Agriculture, Division of Water Resources
 City, State, ZIP Code: **Iuka, Kansas 67066** Application Number:

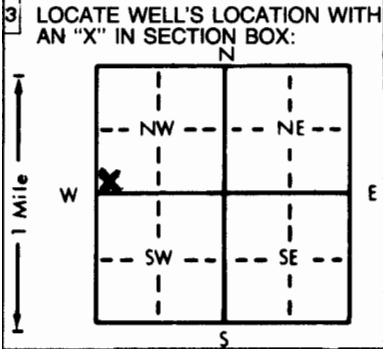

4 DEPTH OF COMPLETED WELL: **80** ft. ELEVATION: ft.
 Depth(s) Groundwater Encountered 1. **39** ft. 2. ft. 3. ft.
 WELL'S STATIC WATER LEVEL: **30** ft. below land surface measured on **14 Nov. 84**
 Pump test data: Well water was ft. after hours pumping gpm
 Est. Yield: **80** gpm: Well water was ft. after hours pumping gpm
 Bore Hole Diameter: **10** in. to **80** ft., and in. to ft.
 WELL WATER TO BE USED AS:
 Domestic 3 Feedlot Oil field water supply 9 Dewatering 12 Other (Specify below)
 2 Irrigation 4 Industrial 7 Lawn and garden only 10 Observation well
 Was a chemical/bacteriological sample submitted to Department? Yes.....No; If yes, mo/day/yr sample was submitted
 Water Well Disinfected? Yes No

5 TYPE OF BLANK CASING USED:
 1 Steel 3 RMP (SR) 5 Wrought iron 8 Concrete tile CASING JOINTS: Glued Clamped
 PVC 4 ABS 6 Asbestos-Cement 9 Other (specify below) Welded
 7 Fiberglass Threaded
 Blank casing diameter: **5** in. to **60** ft., Dia. in. to ft., Dia. in. to ft.
 Casing height above land surface: **12** in., weight **2.34** lbs./ft. Wall thickness or gauge No. **214**
 TYPE OF SCREEN OR PERFORATION MATERIAL:
 1 Steel 3 Stainless steel 5 Fiberglass PVC 10 Asbestos-cement
 2 Brass 4 Galvanized steel 6 Concrete tile 8 RMP (SR) 11 Other (specify)
 12 None used (open hole)
 SCREEN OR PERFORATION OPENINGS ARE:
 1 Continuous slot 3 Mill slot 5 Gauzed wrapped Saw cut 11 None (open hole)
 2 Louvered shutter 4 Key punched 6 Wire wrapped 9 Drilled holes
 7 Torch cut 10 Other (specify)
 SCREEN-PERFORATED INTERVALS: From **60** ft. to **80** ft., From ft. to ft.
 From ft. to ft., From ft. to ft.
 GRAVEL PACK INTERVALS: From **14** ft. to **80** ft., From ft. to ft.
 From ft. to ft., From ft. to ft.

6 GROUT MATERIAL: 1 Neat cement Cement grout 3 Bentonite 4 Other
 Grout Intervals: From **4** ft. to **14** ft., From ft. to ft., From ft. to ft.
 What is the nearest source of possible contamination:
 Septic tank 4 Lateral lines 7 Pit privy 10 Livestock pens 14 Abandoned water well
 2 Sewer lines 5 Cess pool 8 Sewage lagoon 11 Fuel storage 15 Oil well/Gas well
 3 Watertight sewer lines 6 Seepage pit 9 Feedyard 12 Fertilizer storage 16 Other (specify below)
 13 Insecticide storage
 Direction from well? **South** How many feet? **300'**

FROM	TO	LITHOLOGIC LOG	FROM	TO	LITHOLOGIC LOG
0	2	Soil			
2	39	Clay, brown			
39	60	Sand, fine to coarse and fine gravel			
60	80	Sand, fine to coarse and med to coarse gravel, loose			

7 CONTRACTOR'S OR LANDOWNER'S CERTIFICATION: This water well was constructed, (2) reconstructed, or (3) plugged under my jurisdiction and was completed on (mo/day/year) **27 Nov. 84** and this record is true to the best of my knowledge and belief. Kansas Water Well Contractor's License No. **325** This Water Well Record was completed on (mo/day/yr) **29 Jan. 85** under the business name of **Central Well & Pump Inc.** by (signature) *[Signature]*

INSTRUCTIONS: Use typewriter or ball point pen, PLEASE PRESS FIRMLY and PRINT clearly. Please fill in blanks, underline or circle the correct answers. Send top three copies to Kansas Department of Health and Environment, Division of Environment, Environmental Geology Section, Topeka, KS 66620. Send one to WATER WELL OWNER and retain one for your records.

OFFICE USE ONLY T 26 R 14 SEC. 10 S 26 N 14 W 1/4