USE TYPEWRITER OR BALL POINT PEN-PRESS FIRMLY, PRINT CLEARLY.

WATER WELL RECORD
KSA 82a-1201-1215

Kansas Department of Health and Environment-Division of Environment
(Water well Contractors)
Topeka, Kansas 66620

1. Location of well:	County	Fraction	Section number	Township number	Range number
	Pratt	~~SW~~ NE 1/4 NE 1/4 NE 1/4	17	T 26 S	R 14 E/W

2. Distance and direction from nearest town or city:

Street address of well location if in city: (?) Byers, KS

3. Owner of well: Ivan Stotts
R.R. or street:
City, state, zip code: Byers, KS 67021

4. Locate with "X" in section below:

Sketch map:

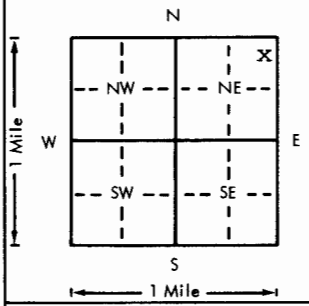

6. Bore hole dia. 9 in. Completion date 9-30-77
Well depth 75 ft.

7. __ Cable tool __ Rotary __ Driven __ Dug
__ Hollow rod __ Jetted __ Bored X Reverse rotary

8. Use: X Domestic __ Public supply __ Industry
__ Irrigation __ Air conditioning __ Stock
__ Lawn __ Oil field water __ Other

9. Casing: Material Styrene Height: Above or below
Threaded ___ Welded x Surface 12 in.
RMP ___ PVC ___ Weight 1.5 lbs./ft.
Dia. 5 in. to 65 ft. depth Wall Thickness: inches or
Dia. ___ in. to ___ ft. depth gage No. 200#

10. Screen: Manufacturer's name Jess & Lowell
Type Styrene 200 Dia. 5"
Slot/gauze 1/8 Length 10'
Set between 65 ft. and 75 ft.
___ ft. and ___ ft.
Gravel pack? yes Size range of material 3/8-200

11. Static water level: mo./day/yr.
21'9" ft. below land surface Date 9-29-77

12. Pumping level below land surfaces: N/C
___ ft. after ___ hrs. pumping ___ g.p.m.
___ ft. after ___ hrs. pumping ___ g.p.m.
Estimated maximum yield ___ g.p.m.

13. Water sample submitted: mo./day/yr.
__ Yes X No Date

14. Well head completion:
__ Pitless adapter 12 Inches above grade

15. Well grouted? yes
With: X Neat cement ___ Bentonite ___ Concrete
Depth: From 0 ft. to 10 ft.

16. Nearest source of possible contamination: FIELD
ft. ___ Direction ___ Type ___
Well disinfected upon completion? X Yes ___ No

17. Pump: __ Not installed
Manufacturer's name Berkeley Pump Co.
Model number 4BL-12 HP 3/4 Volts 230
Length of drop pipe 42 ft. capacity 15 g.p.m.
Type:
X Submersible __ Turbine
__ Jet __ Reciprocating
__ Centrifugal __ Other

5. Type and color of material	From	To
Top soil & gray clay	0	12
Clay - sandy, brown	12	42
Sand & gravel	42	52
Brown clay	52	62
Sand & gravel	62	75

(Use a second sheet if needed)

18. Elevation:

Topography:
__ Hill
__ Slope
__ Upland
__ Valley

19. Remarks:

20. Water well contractor's certification:
This well was drilled under my jurisdiction and this report is true to the best of my knowledge and belief.
Clarke Well & Eq., Inc. 185
Business name License No.
Address Great Bend, KS 67530
Signed O. W. Clark Date 10-5-77
Authorized representative

26 T 14 R (W) E 17 Sec NE 1/4 NE 1/4 NE 1/4

Forward the white, blue and pink copies to the Department of Health and Environment

Form WWC-5

MI-1023