USE TYPEWRITER OR BALL POINT PEN-PRESS FIRMLY, PRINT CLEARLY.

WATER WELL RECORD
KSA 82a-1201-1215

Kansas Department of Health and Environment-Division of Environment
(Water well Contractors)
Topeka, Kansas 66620

1. Location of well:	County: Pratt	Fraction: C SW (1/4 1/4 1/4)	Section number: 17	Township number: T 26 S	Range number: R 14 E/W

2. Distance and direction from nearest town or city: ½ S - 1 W - ½ W
Street address of well location if in city: ½ East From Bypass

3. Owner of well: C E Stacy
R.R. or street: 215 North Mound
City, state, zip code: Pratt, Ks.

4. Locate with "X" in section below:

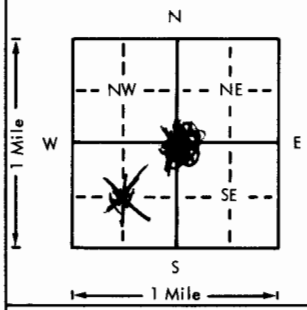

Sketch map:

6. Bore hole dia. 16 in. Completion date 6-3-76
Well depth 131 ft.

7. __ Cable tool ✓ Rotary __ Driven __ Dug
__ Hollow rod __ Jetted __ Bored __ Reverse rotary

8. Use: __ Domestic __ Public supply __ Industry
✓ Irrigation __ Air conditioning __ Stock
__ Lawn __ Oil field water __ Other

9. Casing: Material Steel Height: Above or ~~below~~
Threaded ___ Welded ✓ Surface 18 in.
RMP ___ PVC ___ Weight ___ lbs./ft.
Dia. 16 in. to 131 ft. depth Wall Thickness: inches or
Dia. ___ in. to ___ ft. depth gage No. 7

5. Type and color of material	From	To
Sandy Top Soil	0	2
Dark Brown Clay	2	9
Redish Clay Sandy	9	18
Sandy Gray Clay	18	37
Fine Sand & Gravel	37	43
Gray Sandy Clay	43	49
Gray Clay with Fine Sand	49	66
Sand & Gravel loose	66	97
Gray Clay	97	101
Gray Clay with White Rock	101	117
Sand & Gravel with Clay	117	126
Clean Coarse Sand & Gravel	126	134

(Use a second sheet if needed)

10. Screen: Manufacturer's name Doerrs
Type Steel Dia. 16
Slot/~~gauze~~ 3/16 Length 60
Set between 71 ft. and 131 ft.
___ ft. and ___ ft.
Gravel pack? ___ Size range of material 1/2 3/4 3/8

11. Static water level: mo./day/yr.
18 ft. below land surface Date 2-26-76

12. Pumping level below land surfaces:
20 ft. after 1/4 hrs. pumping 1400 g.p.m.
___ ft. after ___ hrs. pumping ___ g.p.m.
Estimated maximum yield 1400+ g.p.m.

13. Water sample submitted: mo./day/yr.
✓ Yes ___ No Date 3-5-76

14. Well head completion:
___ Pitless adapter ___ Inches above grade

15. Well grouted? ✓
With: ___ Neat cement ___ Bentonite ✓ Concrete
Depth: From 0 ft. to 10 ft.

16. Nearest source of possible contamination:
ft. 3/4 W Direction West Type Creek
Well disinfected upon completion? ___ Yes ___ No

17. Pump: ___ Not installed
Manufacturer's name WLR
Model number 4-CM-12 HP 80 Volts ___
Length of drop pipe 80 ft. capacity 800 g.p.m.
Type:
___ Submersible ✓ Turbine
___ Jet ___ Reciprocating
___ Centrifugal ___ Other

18. Elevation:
Topography:
___ Hill
✓ Slope
___ Upland
___ Valley

19. Remarks:

20. Water well contractor's certification:
This well was drilled under my jurisdiction and this report is true to the best of my knowledge and belief.
Business name Rosencrantz-Bemis License No. 134
Address Great Bend, Ks.
Signed Julia Dodson Date 9/29/76
Authorized representative

26 14 W 17 C SW
T R Sec 1/4 1/4 1/4

Forward the white, blue and pink copies to the Department of Health and Environment

Form WWC-5

MI-1023