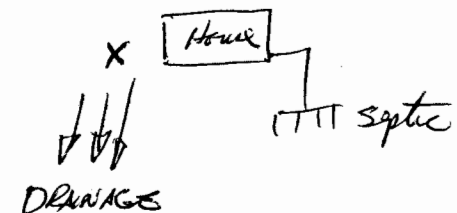


USE TYPEWRITER OR BALL POINT PEN-PRESS FIRMLY, PRINT CLEARLY.

WATER WELL RECORD
KSA 82a-1201-1215

Kansas Department of Health and Environment-Division of Environment
(Water well Contractors)
Topeka, Kansas 66620

1. Location of well:		County PRATT	Fraction NE 1/4 NE 1/4 SE 1/4	Section number 18	Township number T 26 S R 14 W E/W	Range number
2. Distance and direction from nearest town or city: Street address of well location if in city:			3. Owner of well: R., R., or street: City, state, zip code:			
4. Locate with "X" in section below: N W E S 1 Mile 1 Mile			Sketch map: 		6. Bore hole dia. <u>10</u> in. Completion date Well depth <u>55</u> ft. <u>13 July 77</u>	
5. Type and color of material			From	To	7. <input type="checkbox"/> Cable tool <input checked="" type="checkbox"/> Rotary <input type="checkbox"/> Driven <input type="checkbox"/> Dug <input type="checkbox"/> Hollow rod <input type="checkbox"/> Jetted <input type="checkbox"/> Bored <input type="checkbox"/> Reverse rotary	
Soil			0	2	8. Use: <input checked="" type="checkbox"/> Domestic <input type="checkbox"/> Public supply <input type="checkbox"/> Industry <input type="checkbox"/> Irrigation <input type="checkbox"/> Air conditioning <input type="checkbox"/> Stock <input type="checkbox"/> Lawn <input type="checkbox"/> Oil field water <input type="checkbox"/> Other	
Sand, fine			2	5	9. Casing: Material _____ Height <u>Above</u> or below Threaded _____ Welded _____ Surface <u>12</u> in. RMP <input checked="" type="checkbox"/> PVC _____ Weight _____ lbs./ft. Dia <u>5</u> in. to <u>55</u> ft. depth Wall Thickness: inches or Dia. _____ in. to _____ ft. depth gage No. <u>200</u>	
Clay, Sandy gray			5	16	10. Screen: Manufacturer's name _____ Type <u>J&L</u> Dia. <u>5</u> Slot/gauze <u>1/8" Square</u> Length <u>10'</u> Set between <u>45'</u> ft. and <u>55'</u> ft. _____ ft. and _____ ft. Gravel pack? <input checked="" type="checkbox"/> Size range of material <u>1/8" X 1/4"</u>	
Sand, fine silty			16	26	11. Static water level: _____ mo./day/yr. <u>20</u> ft. below land surface Date <u>13 July 77</u>	
Clay, Sandy brown			26	44	12. Pumping level below land surfaces: _____ ft. after _____ hrs. pumping _____ g.p.m. _____ ft. after _____ hrs. pumping _____ g.p.m. Estimated maximum yield <u>40</u> _____ g.p.m.	
Sand, Coarse & med to Coarse gravel			44	55	13. Water sample submitted: _____ mo./day/yr. <input type="checkbox"/> Yes <input checked="" type="checkbox"/> No Date _____	
Clay, white			55	60	14. Well head completion: <input checked="" type="checkbox"/> Pitless adapter <u>12</u> Inches above grade	
					15. Well grouted? <input checked="" type="checkbox"/> With: <input checked="" type="checkbox"/> Neat cement <input type="checkbox"/> Bentonite <input type="checkbox"/> Concrete Depth: From <u>4</u> ft. to <u>14</u> ft.	
					16. Nearest source of possible contamination: ft. <u>75</u> Direction <u>West</u> Type <u>Septic</u> Well disinfected upon completion? <input checked="" type="checkbox"/> Yes <input type="checkbox"/> No	
					17. Pump: <input checked="" type="checkbox"/> Not installed Manufacturer's name _____ Model number _____ HP _____ Volts _____ Length of drop pipe _____ ft. capacity _____ g.p.m. Type: <input type="checkbox"/> Submersible <input type="checkbox"/> Turbine <input type="checkbox"/> Jet <input type="checkbox"/> Reciprocating <input type="checkbox"/> Centrifugal <input type="checkbox"/> Other	
					20. Water well contractor's certification: This well was drilled under my jurisdiction and this report is true to the best of my knowledge and belief. <u>Central Well & Pump</u> <u>325</u> Business name License No. Address <u>121 S. Taylor Pratt</u> Signed <u>Robert M. ...</u> Date <u>13 July 77</u> Authorized representative	
18. Elevation: Topography: <input type="checkbox"/> Hill <input checked="" type="checkbox"/> Slope <input checked="" type="checkbox"/> Upland <input type="checkbox"/> Valley		19. Remarks: <u>4' X 4' X 4" slot below pit adapter</u>				

T 26 S R 14 W E/W Sec 18