


1 LOCATION OF WATER WELL: Fraction Center Section Number 18 Township Number T 26 S Range Number R 14 W EW
 County: Pratt

Distance and direction from nearest town or city street address of well if located within city?
10 3/4 North, 1/4 East, of Cullison

2 WATER WELL OWNER: Jerrie McAhren
 RR#, St. Address, Box #: C/O Stan McAhren Board of Agriculture, Division of Water Resources
 City, State, ZIP Code: Byers, Ks. Application Number: 37,490

3 LOCATE WELL'S LOCATION WITH AN "X" IN SECTION BOX:

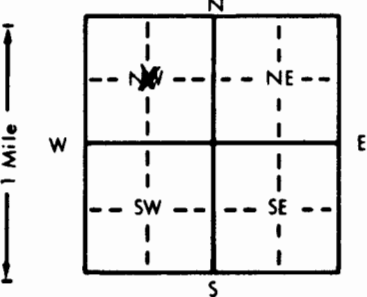

4 DEPTH OF COMPLETED WELL: 154 ft. ELEVATION:
 Depth(s) Groundwater Encountered 1. 44 ft. 2. ft. 3. 10 June 85 ft.
 WELL'S STATIC WATER LEVEL 30 ft. below land surface measured on mo/day/yr
 Pump test data: Well water was 45.3 ft. after 1 hours pumping 1000 gpm
 Est. Yield 1500 gpm: Well water was 48.5 ft. after 1 hours pumping 1200 gpm
 Bore Hole Diameter 30 in. to 154 ft., and in. to ft.
 WELL WATER TO BE USED AS: 5 Public water supply 8 Air conditioning 11 Injection well
 1 Domestic 3 Feedlot 6 Oil field water supply 9 Dewatering 12 Other (Specify below)
 Irrigation 4 Industrial 7 Lawn and garden only 10 Observation well
 Was a chemical/bacteriological sample submitted to Department? Yes.....No; If yes, mo/day/yr sample was submitted
 Water Well Disinfected? Yes No

5 TYPE OF BLANK CASING USED: 1 Steel 3 RMP (SR) 5 Wrought iron 8 Concrete tile CASING JOINTS: Glued Clamped
 4 ABS 6 Asbestos-Cement 9 Other (specify below) Welded xxx
 7 Fiberglass Threaded.....

Blank casing diameter 16 in. to 60 ft., Dia in. to ft., Dia in. to ft.
 Casing height above land surface 12 in., weight 42.05 lbs./ft. Wall thickness or gauge No. 250

TYPE OF SCREEN OR PERFORATION MATERIAL: 1 Steel 3 Stainless steel 5 Fiberglass 8 RMP (SR) 10 Asbestos-cement
 2 Brass 4 Galvanized steel 6 Concrete tile 9 ABS 11 Other (specify)
 12 None used (open hole)

SCREEN OR PERFORATION OPENINGS ARE: 5 Gauzed wrapped 11 None (open hole)
 1 Continuous slot 3 Mill slot 6 Wire wrapped 9 Drilled holes
 2 Louvered shutter 4 Key punched 7 Torch cut 10 Other (specify)

SCREEN-PERFORATED INTERVALS: From 60 ft. to 80 ft., From ft. to ft.
 From 134 ft. to 154 ft., From ft. to ft.
 GRAVEL PACK INTERVALS: From 10 ft. to 154 ft., From ft. to ft.
 From ft. to ft., From ft. to ft.

6 GROUT MATERIAL: 1 Neat cement 3 Bentonite 4 Other

Grout Intervals: From 0 ft. to 10 ft., From ft. to ft., From ft. to ft.
 What is the nearest source of possible contamination:
 1 Septic tank 4 Lateral lines 7 Pit privy 10 Livestock pens 14 Abandoned water well
 2 Sewer lines 5 Cess pool 8 Sewage lagoon 11 Fuel storage 15 Oil well/Gas well
 3 Watertight sewer lines 6 Seepage pit 9 Feedyard 12 Fertilizer storage 16 Other (specify below)
 13 Insecticide storage None

Direction from well? How many feet?

FROM	TO	LITHOLOGIC LOG	FROM	TO	LITHOLOGIC LOG
0	2	Soil			
2	14	Clay, green & blue			
14	44	Clay, tan & green			
44	80	Sand, fine to coarse and fine to very coarse gravel			
80	134	Clay, tan and white			
134	162	Sand, fine to coarse and fine to coarse gravel			
162	180	Clay, tan and red			

7 CONTRACTOR'S OR LANDOWNER'S CERTIFICATION: This water well was 1 constructed, (2) reconstructed, or (3) plugged under my jurisdiction and was completed on (mo/day/year) 10 June 85 and this record is true to the best of my knowledge and belief. Kansas Water Well Contractor's License No. 325. This Water Well Record was completed on (mo/day/yr) 23, Aug. 85 under the business name of Central Well & Pump Inc. by (signature) [Signature]

INSTRUCTIONS: Use typewriter or ball point pen, PLEASE PRESS FIRMLY and PRINT clearly. Please fill in blanks, underline or circle the correct answers. Send top three copies to Kansas Department of Health and Environment, Division of Environment, Environmental Geology Section, Topeka, KS 66620. Send one to WATER WELL OWNER and retain one for your records.

OFFICE USE ONLY
T
R
EW
SEC.