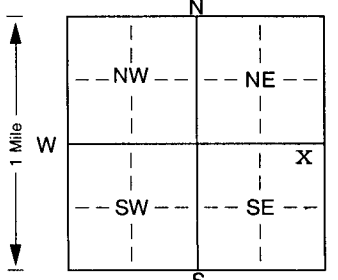


1 LOCATION OF WATER WELL: Fraction Section Number Township Number Range Number
 County: Pratt NE 1/4 NE 1/4 SE 1/4 6 T 26 S R 15W EW

Distance and direction from nearest town or city street address of well if located within city?
 1/2 North of Hopewell

2 WATER WELL OWNER: Eric Smith
 RR#, St. Address, Box # : Rt 1 Box 88 Board of Agriculture, Division of Water Resources
 City, State, ZIP Code : Macksville, KS 67557 Application Number:

3 LOCATE WELL'S LOCATION WITH AN "X" IN SECTION BOX:

 4 DEPTH OF COMPLETED WELL: 80 ft. ELEVATION:
 Depth(s) Groundwater Encountered 1. 20 ft. 2. ft. 3. ft.
 WELL'S STATIC WATER LEVEL: 20 ft. below land surface measured on mo/day/yr
 Pump test data: Well water was ft. after hours pumping gpm
 Est. Yield .50 gpm: Well water was ft. after hours pumping gpm
 Bore Hole Diameter. in. to ft., and in. to ft.
 WELL WATER TO BE USED AS: 5 Public water supply 8 Air conditioning 11 Injection well
 xx Domestic 3 Feedlot 6 Oil field water supply 9 Dewatering 12 Other (Specify below)
 2 Irrigation 4 Industrial 7 Domestic (lawn & garden) 10 Monitoring well
 Was a chemical/bacteriological sample submitted to Department? Yes. No. ; If yes, mo/day/yr sample was submitted
 Water Well Disinfected? Yes No

5 TYPE OF BLANK CASING USED:
 1 Steel 3 RMP (SR) 5 Wrought iron 8 Concrete tile CASING JOINTS: Glued xx Clamped.
 xx PVC 4 ABS 6 Asbestos-Cement 9 Other (specify below) Welded
 7 Fiberglass Threaded.
 Blank casing diameter. 5 in. to 60 ft., Dia. in. to ft., Dia. in. to ft.
 Casing height above land surface. 24 in., weight SDR 26 lbs./ft. Wall thickness or gauge No.
 TYPE OF SCREEN OR PERFORATION MATERIAL: xx PVC 10 Asbestos-cement
 1 Steel 3 Stainless steel 5 Fiberglass 8 RMP (SR) 11 Other (specify)
 2 Brass 4 Galvanized steel 6 Concrete tile 9 ABS 12 None used (open hole)
 SCREEN OR PERFORATION OPENINGS ARE:
 1 Continuous slot xx Mill slot 5 Gauzed wrapped 8 Saw cut 11 None (open hole)
 2 Louvered shutter 4 Key punched 6 Wire wrapped 9 Drilled holes
 7 Torch cut 10 Other (specify) ft.
 SCREEN-PERFORATED INTERVALS: From 60 ft. to 80 ft., From ft. to ft.
 GRAVEL PACK INTERVALS: From 30 ft. to 80 ft., From ft. to ft.
 From ft. to ft., From ft. to ft.

6 GROUT MATERIAL: 1 Neat cement 2 Cement grout xx Bentonite 4 Other
 Grout Intervals: From 2 ft. to 30 ft., From ft. to ft., From ft. to ft.
 What is the nearest source of possible contamination:
 1 Septic tank 4 Lateral lines 7 Pit privy 10 Livestock pens 14 Abandoned water well
 2 Sewer lines 5 Cess pool 8 Sewage lagoon 11 Fuel storage 15 Oil well/Gas well
 3 Watertight sewer lines 6 Seepage pit 9 Feedyard 12 Fertilizer storage 16 Other (specify below)
 13 Insecticide storage
 Direction from well? How many feet?

FROM	TO	LITHOLOGIC LOG	FROM	TO	PLUGGING INTERVALS
0	16	Topsoil & Gray Clay			
16	28	Brown Sandy Clay			
28	35	White Clay			
35	57	Sand Medium to Coarse			
57	62	Clay			
62	85	Sand Medium to Coarse			

7 CONTRACTOR'S OR LANDOWNER'S CERTIFICATION: This water well was xx constructed, (2) reconstructed, or (3) plugged under my jurisdiction and was completed on (mo/day/year) 9-14-01 and this record is true to the best of my knowledge and belief. Kansas Water Well Contractor's Licence No. 6.7.7 This Water Well Record was completed on (mo/day/yr) 9-21-01 under the business name of CLT Inc. by (signature) *Cliff 9/21/01*