


1 LOCATION OF WATER WELL: County: **Pratt** Fraction: **C of 1/4 S 1/2 S 1/2 1/4 NW 1/4** Section Number: **3** Township Number: **T 26 S** Range Number: **R 15** **EW**

Distance and direction from nearest town or city street address of well if located within city?

12N 3W 5/8N 1/4E of Cullison, Kansas

2 WATER WELL OWNER: **Aldebaron Drilling Company** Board of Agriculture, Division of Water Resources
 RR#, St. Address, Box #: **Box 18611** Application Number:
 City, State, ZIP Code: **Wichita, Kansas 67202** Lease: **Neely 1-B**

3 LOCATE WELL'S LOCATION WITH AN "X" IN SECTION BOX:

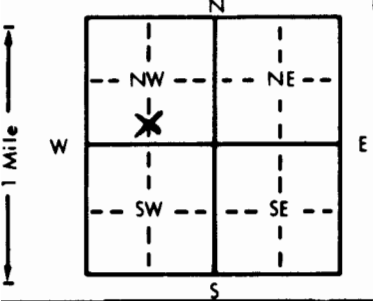

4 DEPTH OF COMPLETED WELL... **100** ft. ELEVATION:
 Depth(s) Groundwater Encountered 1... **25** ft. 2... ft. 3... ft.
 WELL'S STATIC WATER LEVEL **25** ft. below land surface measured on **mo/day/yr** **23 May 84**
 Pump test data: Well water was ... ft. after ... hours pumping ... gpm
 Est. Yield .. **80** gpm: Well water was ... ft. after ... hours pumping ... gpm
 Bore Hole Diameter... **10** in. to ... **100** ft., and... in. to ... ft.
 WELL WATER TO BE USED AS: 5 Public water supply 8 Air conditioning 11 Injection well
 1 Domestic 3 Feedlot **6** Oil field water supply 9 Dewatering 12 Other (Specify below)
 2 Irrigation 4 Industrial 7 Lawn and garden only 10 Observation well
 Was a chemical/bacteriological sample submitted to Department? Yes... No... **X**...; If yes, mo/day/yr sample was submitted
 Water Well Disinfected? Yes **X** No

5 TYPE OF CASING USED: 1 Steel 3 RMP (SR) 5 Wrought iron 8 Concrete tile CASING JOINTS: Glued **X** Clamped
2 PVC 4 ABS 7 Fiberglass 9 Other (specify below) Welded
 Blank casing diameter ... **5** in. to ... **80** ft., Dia ... in. to ... ft., Dia ... in. to ... ft.
 Casing height above land surface ... **12** in., weight ... lbs./ft. Wall thickness or gauge No. **214**

TYPE OF SCREEN OR PERFORATION MATERIAL: 1 Steel 3 Stainless steel 5 Fiberglass **7** PVC 10 Asbestos-cement
 2 Brass 4 Galvanized steel 6 Concrete tile 8 RMP (SR) 11 Other (specify) ...
 12 None used (open hole)
 SCREEN OR PERFORATION OPENINGS ARE: 5 Gauzed wrapped **8** Saw cut 11 None (open hole)
 1 Continuous slot 3 Mill slot 6 Wire wrapped 9 Drilled holes
 2 Louvered shutter 4 Key punched 7 Torch cut 10 Other (specify) ...

SCREEN-PERFORATED INTERVALS: From ... **80** ft. to ... **100** ft., From ... ft. to ... ft.
 GRAVEL PACK INTERVALS: From ... **10** ft. to ... **100** ft., From ... ft. to ... ft.

6 GROUT MATERIAL: 1 Neat cement **2** Cement grout 3 Bentonite 4 Other ...
 Grout Intervals: From ... **0** ft. to ... **10** ft., From ... ft. to ... ft., From ... ft. to ... ft.
 What is the nearest source of possible contamination:
 1 Septic tank 4 Lateral lines 7 Pit privy 11 Fuel storage 14 Abandoned water well
 2 Sewer lines 5 Cess pool 8 Sewage lagoon 12 Fertilizer storage 15 Oil well/Gas well
 3 Watertight sewer lines 6 Seepage pit 9 Feedyard 13 Insecticide storage 16 Other (specify below)
 None

Direction from well? How many feet?

FROM	TO	LITHOLOGIC LOG	FROM	TO	LITHOLOGIC LOG
0	2	Soil, top			
2	6	Sand, fine			
6	21	Clay, tan and green			
21	57	Sand, fine to coarse and fine gravel with clay			
57	80	Clay, white			
80	100	Sand, coarse and coarse gravel			

7 CONTRACTOR'S OR LANDOWNER'S CERTIFICATION: This water well was **1** constructed, (2) reconstructed, or (3) plugged under my jurisdiction and was completed on (mo/day/year) **23 May 84** and this record is true to the best of my knowledge and belief. Kansas Water Well Contractor's License No. **325** This Water Well Record was completed on (mo/day/yr) **7 June 84** under the business name of **Central Well & Pump Inc.** by (signature) *[Signature]*

INSTRUCTIONS: Use typewriter or ball point pen, PLEASE PRESS FIRMLY and PRINT clearly. Please fill in blanks, underline or circle the correct answers. Send top three copies to Kansas Department of Health and Environment, Division of Environment, Environmental Geology Section, Topeka, KS 66620. Send one to WATER WELL OWNER and retain one for your records.

OFFICE USE ONLY
T
R
EW
SEC.