


1 LOCATION OF WATER WELL: County: Pratt Fraction: SW 1/4 NE 1/4 NE 1/4 Section Number: 7 Township Number: T 26 S Range Number: R 15 EW

Distance and direction from nearest town or city street address of well if located within city?

In Hopewell, Kans.

2 WATER WELL OWNER: Leslie Adams Board of Agriculture, Division of Water Resources
 RR#, St. Address, Box #: Macksville Kansas Application Number:

3 LOCATE WELL'S LOCATION WITH AN "X" IN SECTION BOX: 4 DEPTH OF COMPLETED WELL: 80 ft. ELEVATION: 26 ft.

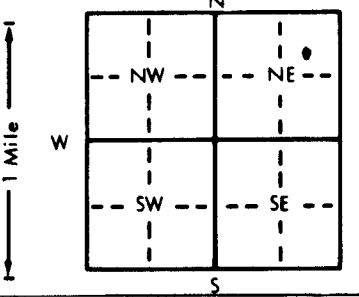

Depth(s) Groundwater Encountered 1. 26 ft. 2. 80 ft. 3. 80 ft.
 WELL'S STATIC WATER LEVEL 26 ft. below land surface measured on mo/day/yr
 Pump test data: Well water was No Pump hours pumping 0 gpm
 Est. Yield 25 gpm: Well water was 80 ft. after 0 hours pumping 0 gpm
 Bore Hole Diameter: 8 3/4 in. to 80 ft., and 0 in. to 0 ft.
 WELL WATER TO BE USED AS:
 1 Domestic 3 Feedlot 6 Oil field water supply 9 Dewatering 12 Other (Specify below)
 2 Irrigation 4 Industrial 7 Lawn and garden only 10 Observation well
 Was a chemical/bacteriological sample submitted to Department? Yes X No X; If yes, mo/day/yr sample was submitted
 Water Well Disinfected? Yes X No X

5 TYPE OF BLANK CASING USED:
 1 Steel 2 PVC 3 RMP (SR) 4 ABS 5 Wrought iron 6 Asbestos-Cement 7 Fiberglass 8 Concrete tile 9 Other (specify below) 10 Asbestos-cement
 CASING JOINTS: Glued X Clamped 0 Welded 0 Threaded 0

Blank casing diameter 8 in. to 80 ft., Dia. 0 in. to 0 ft., Dia. 0 in. to 0 ft.
 Casing height above land surface 14 in., weight 2 lbs./ft. Wall thickness or gauge No. SDR-26

TYPE OF SCREEN OR PERFORATION MATERIAL:
 1 Steel 2 Brass 3 Stainless steel 4 Galvanized steel 5 Fiberglass 6 Concrete tile 7 PVC 8 RMP (SR) 9 ABS 10 Asbestos-cement 11 Other (specify) 12 None used (open hole)

SCREEN OR PERFORATION OPENINGS ARE:
 1 Continuous slot 2 Louvered shutter 3 Mill slot 4 Key punched 5 Gauzed wrapped 6 Wire wrapped 7 Torch cut 8 Saw cut 9 Drilled holes 11 None (open hole)

SCREEN-PERFORATED INTERVALS: From 50 ft. to 80 ft., From 0 ft. to 0 ft., From 0 ft. to 0 ft.
 GRAVEL PACK INTERVALS: From 20 ft. to 80 ft., From 0 ft. to 0 ft., From 0 ft. to 0 ft.

6 GROUT MATERIAL: 1 Neat cement 2 Cement grout 3 Bentonite 4 Other
 Grout Intervals: From 0 ft. to 14 ft., From 0 ft. to 0 ft., From 0 ft. to 0 ft.

What is the nearest source of possible contamination:
 1 Septic tank 2 Sewer lines 3 Watertight sewer lines 4 Lateral lines 5 Cess pool 6 Seepage pit 7 Pit privy 8 Sewage lagoon 9 Feedyard 10 Livestock pens 11 Fuel storage 12 Fertilizer storage 13 Insecticide storage 14 Abandoned water well 15 Oil well/Gas well 16 Other (specify below)
 Direction from well? S.W. How many feet? 70

FROM	TO	LITHOLOGIC LOG	FROM	TO	LITHOLOGIC LOG
0	1	Top Soil			
1	3	BR. Clay			
3	4	Rusty Silty Sand			
4	16	BR. Clay			
16	21	Sand & Gravel			
21	25	White Clay Gyphack			
25	38	BR. Clay & Sand streaks			
38	56	Sand & Gravel			
56	64	Beige Clay			
64	80	Sand & Gravel			

7 CONTRACTOR'S OR LANDOWNER'S CERTIFICATION: This water well was (1) constructed, (2) reconstructed, or (3) plugged under my jurisdiction and was completed on (mo/day/year) 5-4-81 and this record is true to the best of my knowledge and belief. Kansas Water Well Contractor's License No. 224 225 This Water Well Record was completed on (mo/day/yr) 7-5-81 under the business name of Carl Kayse Water Well Sew. by (signature) Carl Kayse

INSTRUCTIONS: Use typewriter or ball point pen, PLEASE PRESS FIRMLY and PRINT clearly. Please fill in blanks, underline or circle the correct answers. Send top three copies to Kansas Department of Health and Environment, Division of Environment, Environmental Geology Section, Topeka, KS 66620. Send one to WATER WELL OWNER and retain one for your records.

OFFICE USE ONLY T RB 15 BW SEC. 7 1/4 SW 1/4 NE 1/4 NW 1/4