


1 LOCATION OF WATER WELL: County: Pratt Fraction: C 1/4 SE 1/4 NW 1/4 Section Number: 14 Township Number: T 26 S Range Number: R 15 E/W

Distance and direction from nearest town or city street address of well if located within city?
3 1/2 west of Byers

2 WATER WELL OWNER: Glen Curtis Texas Energies
 RR#, St. Address, Box #: Box 176 Box 176 Board of Agriculture, Division of Water Resources
 City, State, ZIP Code: Macksville, Ks. Pratt, Ks. 67124 Application Number: T82-174

3 LOCATE WELL'S LOCATION WITH AN "X" IN SECTION BOX: N
 4 DEPTH OF COMPLETED WELL: 100 ft. ELEVATION:

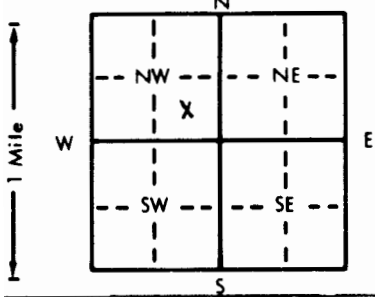

Depth(s) Groundwater Encountered 1. 14 ft. 2. ft. 3. ft.
 WELL'S STATIC WATER LEVEL 25 ft. below land surface measured on mo/day/yr 3-24-82
 Pump test data: Well water was ft. after hours pumping gpm
 Est. Yield NA gpm: Well water was ft. after hours pumping gpm
 Bore Hole Diameter 11 in. to 100 ft., and in. to ft.
 WELL WATER TO BE USED AS: 5 Public water supply 8 Air conditioning 11 Injection well
 1 Domestic 3 Feedlot 6 Oil field water supply 9 Dewatering 12 Other (Specify below)
 2 Irrigation 4 Industrial 7 Lawn and garden only 10 Observation well
 Was a chemical/bacteriological sample submitted to Department? Yes.....No x.....; If yes, mo/day/yr sample was submitted
 Water Well Disinfected? Yes HTH No

5 TYPE OF BLANK CASING USED: 5 Wrought iron 8 Concrete tile CASING JOINTS: Glued x Clamped
 1 Steel 3 RMP (SR) 6 Asbestos-Cement 9 Other (specify below) Welded
8 PVC 4 ABS 7 Fiberglass Threaded.....

Blank casing diameter 5 in. to 60 ft., Dia in. to ft., Dia in. to ft.
 Casing height above land surface 18 in., weight lbs./ft. Wall thickness or gauge No. 258

TYPE OF SCREEN OR PERFORATION MATERIAL: 8 PVC 10 Asbestos-cement
 1 Steel 3 Stainless steel 5 Fiberglass 8 RMP (SR) 11 Other (specify)
 2 Brass 4 Galvanized steel 6 Concrete tile 9 ABS 12 None used (open hole)

SCREEN OR PERFORATION OPENINGS ARE: 5 Gauzed wrapped 8 Saw cut 11 None (open hole)
 1 Continuous slot 3 Mill slot 6 Wire wrapped 9 Drilled holes
 2 Louvered shutter 4 Key punched 7 Torch cut 10 Other (specify)

SCREEN-PERFORATED INTERVALS: From 60 ft. to 100 ft., From ft. to ft.
 From ft. to ft., From ft. to ft.
 GRAVEL PACK INTERVALS: From 10 ft. to 100 ft., From ft. to ft.
 From ft. to ft., From ft. to ft.

6 GROUT MATERIAL: 8 Neat cement 2 Cement grout 3 Bentonite 4 Other
 Grout Intervals: From 0 ft. to 10 ft., From ft. to ft., From ft. to ft.

What is the nearest source of possible contamination:
 1 Septic tank 4 Lateral lines 7 Pit privy 10 Livestock pens 14 Abandoned water well
 2 Sewer lines 5 Cess pool 8 Sewage lagoon 11 Fuel storage 80 Oil well/Gas well
 3 Watertight sewer lines 6 Seepage pit 9 Feedyard 12 Fertilizer storage 16 Other (specify below)
 13 Insecticide storage
 Direction from well? North west How many feet? 75

FROM	TO	LITHOLOGIC LOG	FROM	TO	LITHOLOGIC LOG
0	5	Sandy top soil			
5	28	Brown sandy clay			
28	45	Brown and gray clay			
45	60	Sandy clay-sand and gravel			
60	73	Sand and gravel			
73	76	Sandy clay			
76	100	Sand and gravel			

7 CONTRACTOR'S OR LANDOWNER'S CERTIFICATION: This water well was (1) constructed, (2) reconstructed, or (3) plugged under my jurisdiction and was completed on (mo/day/year) 3-24-82 and this record is true to the best of my knowledge and belief. Kansas Water Well Contractor's License No. 134 This Water Well Record was completed on (mo/day/yr) 3-30-82 under the business name of Rosencrantz-Bemis Ent. by (signature) Rora Dodson

INSTRUCTIONS: Use typewriter or ball point pen, PLEASE PRESS FIRMLY and PRINT clearly. Please fill in blanks, underline or circle the correct answers. Send top three copies to Kansas Department of Health and Environment, Division of Environment, Environmental Geology Section, Topeka, KS 66620. Send one to WATER WELL OWNER and retain one for your records.

OFFICE USE ONLY
T 26 S
R 15 E/W
SEC. 14
2 1/4 SE 1/4 NW 1/4