USE TYPEWRITER OR BALL POINT PEN-PRESS FIRMLY, PRINT CLEARLY.

WATER WELL RECORD
KSA 82a-1201-1215

Kansas Department of Health and Environment-Division of Environment
(Water well Contractors)
Topeka, Kansas 66620

| 1. Location of well: | County | Fraction | Section number | Township number | Range number |
|---|---|---|---|---|---|
| | Pratt | SW 1/4 NW 1/4 SW 1/4 | 25 | T 26 S | R 15 E (W) |

2. Distance and direction from nearest town or city:
5 miles ~~west~~ South of Byers, KS
Street address of well location if in city:

3. Owner of well: Harry W. Carr
R.R. or street: Route 3
City, state, zip code: Pratt, KS 67124

4. Locate with "X" in section below:

Sketch map:

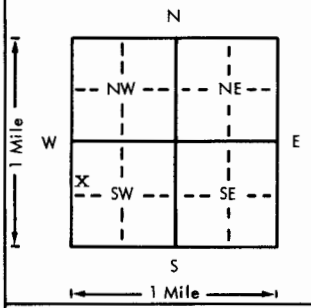


6. Bore hole dia. 9 in. Completion date 9-28-77
Well depth 80 ft.

7. __ Cable tool __ Rotary __ Driven __ Dug
__ Hollow rod __ Jetted __ Bored XX Reverse rotary

8. Use: __ Domestic __ Public supply __ Industry
__ Irrigation __ Air conditioning X Stock
__ Lawn __ Oil field water __ Other

9. Casing: Material Styrene Height: (Above) or below
Threaded ___ Welded X Surface 12 in.
RMP ___ PVC ___ Weight 1.5 lbs./ft.
Dia. 5 in. to 60 ft. depth Wall Thickness: inches or
Dia. ___ in. to ___ ft. depth gage No. .200

| 5. Type and color of material | From | To |
|---|---|---|
| Sandy top soil | 0 | 11 |
| Blue clay | 11 | 18 |
| Brown & white clay | 18 | 43 |
| Sand & gravel | 43 | 48 |
| Hard yellow clay | 48 | 63 |
| Sand & gravel | 63 | 80 |

(Use a second sheet if needed)

10. Screen: Manufacturer's name Jess & Lowell
Type Styrene 200 Dia. 5"
(Slot) gauze 1/8 Length 20'
Set between 60 ft. and 80 ft.
___ ft. and ___ ft.
Gravel pack yes Size range of material 3/8-200

11. Static water level: mo./day/yr.
26'6" ft. below land surface Date 9-28-77

12. Pumping level below land surfaces: N/C
___ ft. after ___ hrs. pumping ___ g.p.m.
___ ft. after ___ hrs. pumping ___ g.p.m.
Estimated maximum yield ___ g.p.m.

13. Water sample submitted: mo./day/yr.
___ Yes X No Date

14. Well head completion: 12
___ Pitless adapter XXX Inches above grade

15. Well grouted? yes
With: X Neat cement ___ Bentonite ___ Concrete
Depth: From 0 ft. to 10 ft.

16. Nearest source of possible contamination: FIELD
ft. ___ Direction ___ Type ___
Well disinfected upon completion? X Yes ___ No

17. Pump: X Not installed
Manufacturer's name ___
Model number ___ HP ___ Volts ___
Length of drop pipe ___ ft. capacity ___ g.p.m.
Type:
___ Submersible ___ Turbine
___ Jet ___ Reciprocating
___ Centrifugal ___ Other

18. Elevation:

Topography:
___ Hill
___ Slope
___ Upland
___ Valley

19. Remarks:

20. Water well contractor's certification:
This well was drilled under my jurisdiction and this report is true to the best of my knowledge and belief.
Clarke Well & Eq., Inc. 185
Business name License No.
Address Great Bend, KS 67530
Signed [signature] Date 9-29-77
Authorized representative

T 26 R 15 E (W) Sec 25 1/4 SW 1/4 NW 1/4 SW

Forward the white, blue and pink copies to the Department of Health and Environment

Form WWC-5

MI-1023