


1 LOCATION OF WATER WELL: Fraction NE 1/4 NW 1/4 SE 1/4 Section Number 30 Township Number T 26 S Range Number R 15 E 17

Distance and direction from nearest town or city street address of well if located within city?
 3 1/2 miles south 1/2 mile west of Hopedell

2 WATER WELL OWNER: Earl Chitwood Trust The Peoples Bank
 RR#, St. Address, Box #: 222 South Main Board of Agriculture, Division of Water Resources
 City, State, ZIP Code: Pratt, Kansas 67124 Application Number:

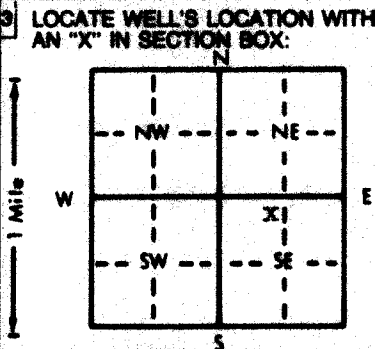

4 DEPTH OF COMPLETED WELL... 68 ft. ELEVATION: ...
 Depth(s) Groundwater Encountered 1... 24 ft. 2... ft. 3... ft.
 WELL'S STATIC WATER LEVEL... 24 ft. below land surface measured on mo/day/yr 3/14/89
 Pump test data: Well water was 24 ft. after 1/2 hours pumping 100 gpm
 Est. Yield 100 gpm: Well water was ft. after hours pumping gpm
 Bore Hole Diameter... in. to ft., and... in. to ft.
 WELL WATER TO BE USED AS: 5 Public water supply 8 Air conditioning 11 Injection well
 X1 Domestic 3 Feedlot 6 Oil field water supply 9 Dewatering 12 Other (Specify below)
 2 Irrigation 4 Industrial 7 Lawn and garden only 10 Observation well
 Was a chemical/bacteriological sample submitted to Department? Yes... No... X...; if yes, mo/day/yr sample was submitted
 Water Well Disinfected? Yes X No

5 TYPE OF BLANK CASING USED: 5 Wrought iron 8 Concrete tile CASING JOINTS: Glued X Clamped
 1 Steel 3 RMP (SR) 6 Asbestos-Cement 9 Other (specify below) Welded
 X 2 PVC 4 ABS 7 Fiberglass Threaded
 Blank casing diameter 5 in. to 48 ft., Dia in. to ft., Dia in. to ft.
 Casing height above land surface 18 in., weight lbs./ft. Wall thickness or gauge No. SDR-26
 TYPE OF SCREEN OR PERFORATION MATERIAL: X PVC 10 Asbestos-cement
 1 Steel 3 Stainless steel 5 Fiberglass 8 RMP (SR) 11 Other (specify)
 2 Brass 4 Galvanized steel 6 Concrete tile 9 ABS 12 None used (open hole)
 SCREEN OR PERFORATION OPENINGS ARE: 5 Gauzed wrapped X 8 Saw cut 11 None (open hole)
 1 Continuous slot 3 Mill slot 6 Wire wrapped 9 Drilled holes
 2 Louvered shutter 4 Key punched 7 Torch cut 10 Other (specify)
 SCREEN-PERFORATED INTERVALS: From 48 ft. to 68 ft., From ft. to ft.
 From ft. to ft., From ft. to ft.
 GRAVEL PACK INTERVALS: From 20 ft. to 28.68 ft., From ft. to ft.
 From ft. to ft., From ft. to ft.

6 GROUT MATERIAL: 1 Neat cement 2 Cement grout X3 Bentonite 4 Other
 Grout intervals: From 0 ft. to 20 ft., From ft. to ft. to ft. to ft.
 What is the nearest source of possible contamination:
 1 Septic tank 4 Lateral line 7 Pit privy 10 Livestock pens 14 Abandoned water well
 2 Sewer line 5 Cess pool 8 Sewage lagoon 11 Fuel storage 15 Oil well/Gas well
 3 Watertight sewer lines 6 Seepage pit 9 Feedyard 12 Fertilizer storage 16 Other (specify below)
 13 Insecticide storage Livestock
 Direction from well? All How many feet? 5

FROM	TO	LITHOLOGIC LOG	FROM	TO	LITHOLOGIC LOG
0	2	Top soil			
2	25	Gray clay			
25	30	Tan sandy clay			
30	48	Sand			
48	51	Clay			
51	68	Sand & gravel			

7 CONTRACTOR'S OR LANDOWNER'S CERTIFICATION: This water well was (1) constructed, (2) reconstructed, or (3) plugged under my jurisdiction and was completed on (mo/day/year) 3/14/89 and this record is true to the best of my knowledge and belief. Kansas
 Water Well Contractor's License No. 224 This Water Well Record was completed on (mo/day/yr) 8/14/89
 under the business name of Carl Hays Water Well Service by (signature) Carl Hays
 INSTRUCTIONS: Use typewriter or ball point pen. PLEASE PRESS FIRMLY and PRINT clearly. Please fill in blanks, underline or circle the correct answers. Send three copies to Kansas Department of Health and Environment, Bureau of Water Protection, Topeka, Kansas 66620-7320, Telephone: 913-882-9380. Send one to WATER WELL OWNER and retain one for your records.